



BUILDING GRADE CERTIFICATE

Town of Sylvan Lake
 Issued by: _____ No. _____

1. WHEN EXCAVATING IN A RIGHT OF WAY (EASEMENT), CHECK FOR UTILITIES.
2. STANDING AT THE WATER SHUTOFF AND FACING THE BUILDING, THE SANITARY SERVICE (PAINTED RED) IS ON THE LEFT SIDE OF THE WATER SERVICE; STORM SERVICE (PAINTED GREEN) IS ON THE RIGHT SIDE OF THE WATER SERVICE.
3. ALL DIMENSIONS ARE IN METRES AND DECIMALS THERE OF. THE ELEVATIONS ARE IN METRES ABOVE GEODETIC MEAN SEA LEVEL.
4. ELEVATIONS NOTED ON THE CERTIFICATE ARE WITHIN 100mm OF ACTUAL.
5. THE BUILDER MUST CONSTRUCT WITHIN 100mm OF THE DESIGN LANDSCAPE ELEVATION & ILLUSTRATED DRAINAGE PATTERNS UNLESS OTHERWISE APPROVED BY THE DEVELOPMENT OFFICER.
6. IF THE INFORMATION ON THIS CERTIFICATE HAS BEEN PREPARED BY A PRIVATE DEVELOPER OR THEIR AGENT, THE TOWN OF SYLVAN LAKE ACCEPTS NO RESPONSIBILITY FOR ITS ACCURACY.

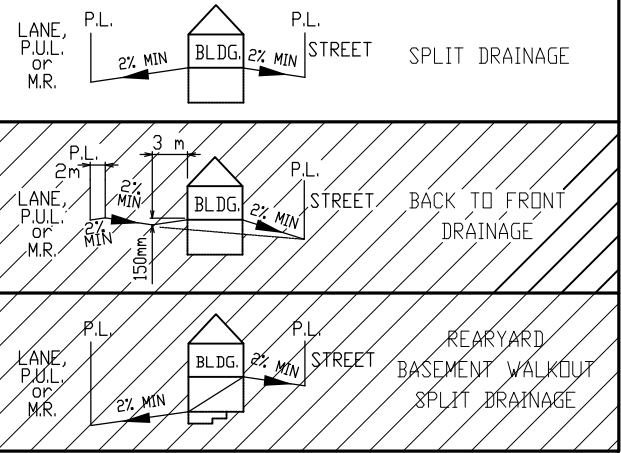

- LEGEND**
- SAN, WATER & STORM
 - ⊙ FIRE HYDRANT
 - - - GAS
 - ☀ POWER, TELEPHONE & CABLE SERVICE
 - STREET LIGHT
 - ⊠ COMMUNITY MAILBOX
 - TRANSFORMER
 - EL&P TRANSFORMER
 - SHAW PEDESTAL
 - ▲ TELEPHONE PEDESTAL
 - URD BOX

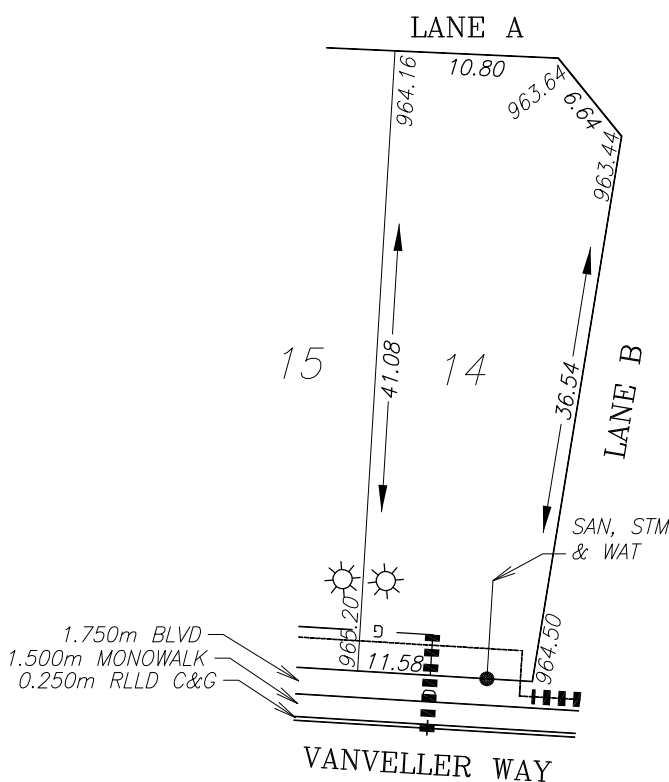

WATER, SANITARY AND STORM SERVICE LOCATION IS 3.0m FROM LOTLINE

TOP OF FOOTING: MAX. DEPTH BELOW AVERAGE SIDEWALK = <u>2.07</u> LOWEST ELEVATION = <u>962.78</u>	CIVIC ADDRESS: <u>8 VANVELLER WAY</u> LOT: <u>14</u> BLOCK: <u>2</u> PLAN No.: <u>132 5350</u> DEVELOPER: <u>WHITECAP COMMUNITIES INC</u> SCALE: <u>1:500</u> DRAWN BY: <u>STANTEC CONSULTING LTD</u> DATE: <u>MAY 24, 2013</u> APPROVED BY: <u>C.G., P. ENG</u> DATE: <u>-</u> RECEIVED BY: _____ DATE: _____
AS-BUILT SEWER INVERT ELEVATIONS: SANITARY AT 5.0m INSIDE LOT = <u>961.93</u> STORM AT 5.0m INSIDE LOT = <u>961.93</u>	


DESIGN LANDSCAPE ELEVATIONS
 ELEV. AT FRONT OF HOUSE = 965.50
 ELEV. AT REAR OF HOUSE = 964.46

I CERTIFY THAT THE FINAL LANDSCAPE GRADE WILL BE (FRONT) _____
 (REAR) _____
 SIGNATURE OF OWNER OR REPRESENTATIVE _____

BUILDING GRADE CERTIFICATE


Town of Sylvan Lake
 Issued by: _____ No. _____

1. WHEN EXCAVATING IN A RIGHT OF WAY (EASEMENT), CHECK FOR UTILITIES.
2. STANDING AT THE WATER SHUTOFF AND FACING THE BUILDING, THE SANITARY SERVICE (PAINTED RED) IS ON THE LEFT SIDE OF THE WATER SERVICE; STORM SERVICE (PAINTED GREEN) IS ON THE RIGHT SIDE OF THE WATER SERVICE.
3. ALL DIMENSIONS ARE IN METRES AND DECIMALS THERE OF. THE ELEVATIONS ARE IN METRES ABOVE GEODETIC MEAN SEA LEVEL.
4. ELEVATIONS NOTED ON THE CERTIFICATE ARE WITHIN 100mm OF ACTUAL.
5. THE BUILDER MUST CONSTRUCT WITHIN 100mm OF THE DESIGN LANDSCAPE ELEVATION & ILLUSTRATED DRAINAGE PATTERNS UNLESS OTHERWISE APPROVED BY THE DEVELOPMENT OFFICER.
6. IF THE INFORMATION ON THIS CERTIFICATE HAS BEEN PREPARED BY A PRIVATE DEVELOPER OR THEIR AGENT, THE TOWN OF SYLVAN LAKE ACCEPTS NO RESPONSIBILITY FOR ITS ACCURACY.

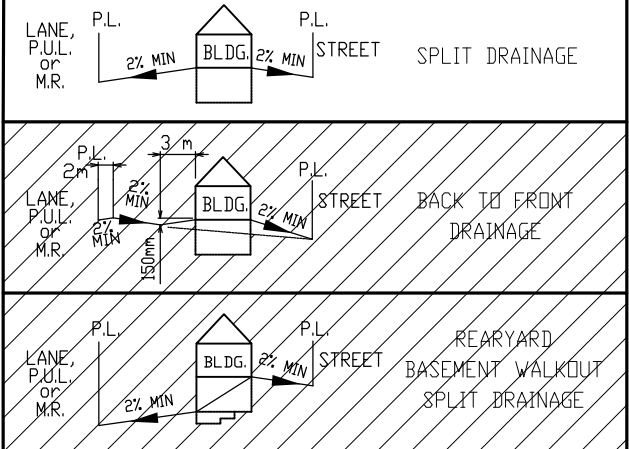

LEGEND

- SAN, WATER & STORM
- ⊙ FIRE HYDRANT
- - - GAS
- ☀ POWER, TELEPHONE & CABLE SERVICE
- STREET LIGHT
- ⊠ COMMUNITY MAILBOX
- TRANSFORMER
- EL&P TRANSFORMER
- SHAW PEDESTAL
- ▲ TELEPHONE PEDESTAL
- URD BOX

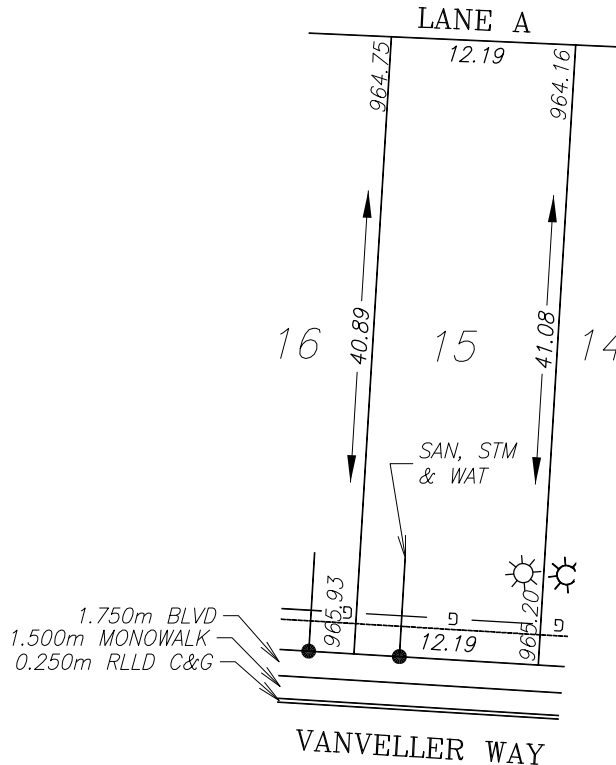

WATER, SANITARY AND STORM SERVICE LOCATION IS 3.0m FROM LOTLINE

TOP OF FOOTING:
 MAX. DEPTH BELOW AVERAGE SIDEWALK = 1.72
 LOWEST ELEVATION = 963.85

AS-BUILT SEWER INVERT ELEVATIONS:
 SANITARY AT 5.0m INSIDE LOT = 963.00
 STORM AT 5.0m INSIDE LOT = 963.00

CIVIC ADDRESS: 10 VANVELLER WAY
 LOT: 15 BLOCK: 2 PLAN No.: 132 5350
 DEVELOPER: WHITECAP COMMUNITIES INC SCALE: 1:500
 DRAWN BY: STANTEC CONSULTING LTD DATE: MAY 24, 2013
 APPROVED BY: C.G., P. ENG DATE: -
 RECEIVED BY: _____ DATE: _____




DESIGN LANDSCAPE ELEVATIONS
 ELEV. AT FRONT OF HOUSE = 966.23
 ELEV. AT REAR OF HOUSE = 965.05

I CERTIFY THAT THE FINAL LANDSCAPE GRADE WILL BE (FRONT) _____
 (REAR) _____
 SIGNATURE OF OWNER OR REPRESENTATIVE _____


BUILDING GRADE CERTIFICATE

Town of Sylvan Lake
 Issued by: _____ No. _____

1. WHEN EXCAVATING IN A RIGHT OF WAY (EASEMENT), CHECK FOR UTILITIES.
2. STANDING AT THE WATER SHUTOFF AND FACING THE BUILDING, THE SANITARY SERVICE (PAINTED RED) IS ON THE LEFT SIDE OF THE WATER SERVICE; STORM SERVICE (PAINTED GREEN) IS ON THE RIGHT SIDE OF THE WATER SERVICE.
3. ALL DIMENSIONS ARE IN METRES AND DECIMALS THERE OF. THE ELEVATIONS ARE IN METRES ABOVE GEODETIC MEAN SEA LEVEL.
4. ELEVATIONS NOTED ON THE CERTIFICATE ARE WITHIN 100mm OF ACTUAL.
5. THE BUILDER MUST CONSTRUCT WITHIN 100mm OF THE DESIGN LANDSCAPE ELEVATION & ILLUSTRATED DRAINAGE PATTERNS UNLESS OTHERWISE APPROVED BY THE DEVELOPMENT OFFICER.
6. IF THE INFORMATION ON THIS CERTIFICATE HAS BEEN PREPARED BY A PRIVATE DEVELOPER OR THEIR AGENT, THE TOWN OF SYLVAN LAKE ACCEPTS NO RESPONSIBILITY FOR ITS ACCURACY.

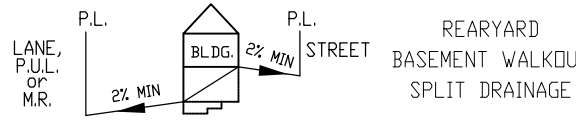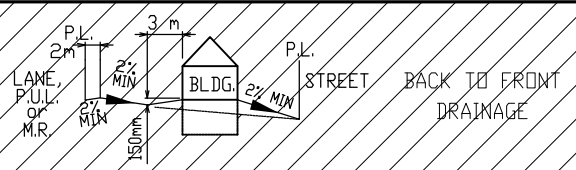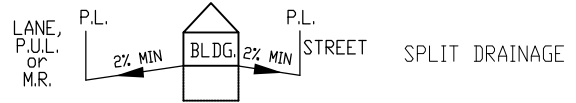

- LEGEND**
- SAN, WATER & STORM
 - ⊙ FIRE HYDRANT
 - - - GAS
 - ☀ POWER, TELEPHONE & CABLE SERVICE
 - ⊙ STREET LIGHT
 - ⊠ COMMUNITY MAILBOX
 - TRANSFORMER
 - EL&P TRANSFORMER
 - SHAW PEDESTAL
 - ▲ TELEPHONE PEDESTAL
 - URD BOX

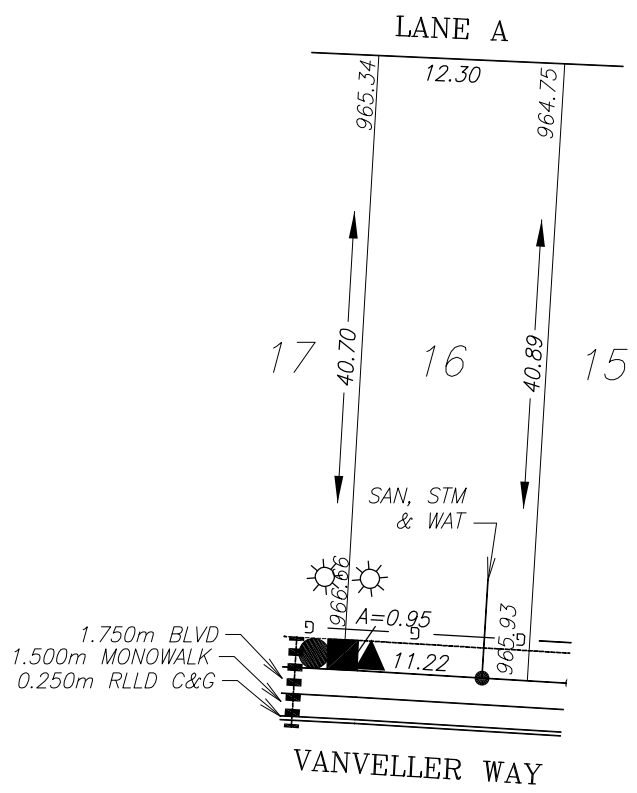

WATER, SANITARY AND STORM SERVICE LOCATION IS 3.0m FROM LOTLINE

TOP OF FOOTING: MAX. DEPTH BELOW AVERAGE SIDEWALK = <u>2.09</u> LOWEST ELEVATION = <u>964.21</u>	AS-BUILT SEWER INVERT ELEVATIONS: SANITARY AT 5.0m INSIDE LOT = <u>963.36</u> STORM AT 5.0m INSIDE LOT = <u>963.36</u>
--	--

CIVIC ADDRESS: <u>12 VANVELLER WAY</u>	LOT: <u>16</u> BLOCK: <u>2</u> PLAN No.: <u>132 5350</u>
DEVELOPER: <u>WHITECAP COMMUNITIES INC</u>	SCALE: <u>1:500</u>
DRAWN BY: <u>STANTEC CONSULTING LTD</u>	DATE: <u>MAY 24, 2013</u>
APPROVED BY: <u>C.G., P. ENG</u>	DATE: <u>-</u>
RECEIVED BY: _____	DATE: _____



DESIGN LANDSCAPE ELEVATIONS ELEV. AT FRONT OF HOUSE = <u>966.96</u> ELEV. AT REAR OF HOUSE = <u>965.64</u>
--

I CERTIFY THAT THE FINAL LANDSCAPE GRADE WILL BE (FRONT) _____
 (REAR) _____
 SIGNATURE OF OWNER OR REPRESENTATIVE _____

BUILDING GRADE CERTIFICATE

Town of Sylvan Lake
 Issued by: No.

1. WHEN EXCAVATING IN A RIGHT OF WAY (EASEMENT), CHECK FOR UTILITIES.
2. STANDING AT THE WATER SHUTOFF AND FACING THE BUILDING, THE SANITARY SERVICE (PAINTED RED) IS ON THE LEFT SIDE OF THE WATER SERVICE; STORM SERVICE (PAINTED GREEN) IS ON THE RIGHT SIDE OF THE WATER SERVICE.
3. ALL DIMENSIONS ARE IN METRES AND DECIMALS THERE OF. THE ELEVATIONS ARE IN METRES ABOVE GEODETIC MEAN SEA LEVEL.
4. ELEVATIONS NOTED ON THE CERTIFICATE ARE WITHIN 100mm OF ACTUAL.
5. THE BUILDER MUST CONSTRUCT WITHIN 100mm OF THE DESIGN LANDSCAPE ELEVATION & ILLUSTRATED DRAINAGE PATTERNS UNLESS OTHERWISE APPROVED BY THE DEVELOPMENT OFFICER.
6. IF THE INFORMATION ON THIS CERTIFICATE HAS BEEN PREPARED BY A PRIVATE DEVELOPER OR THEIR AGENT, THE TOWN OF SYLVAN LAKE ACCEPTS NO RESPONSIBILITY FOR ITS ACCURACY.

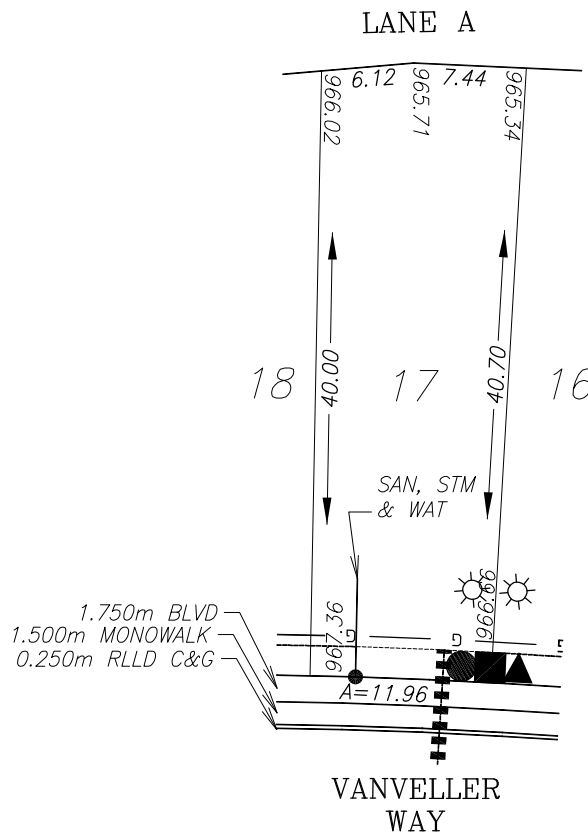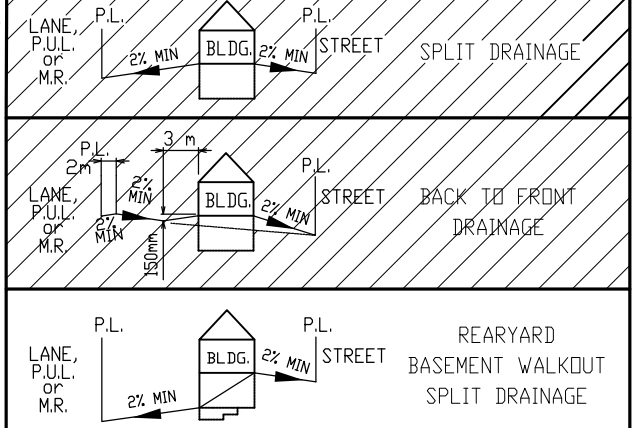

LEGEND

- SAN, WATER & STORM
- ⊙ FIRE HYDRANT
- - - GAS
- ☀ POWER, TELEPHONE & CABLE SERVICE
- STREET LIGHT
- ⊠ COMMUNITY MAILBOX
- TRANSFORMER
- EL&P TRANSFORMER
- SHAW PEDESTAL
- ▲ TELEPHONE PEDESTAL
- URD BOX

WATER, SANITARY AND STORM SERVICE LOCATION IS 3.0m FROM LOTLINE

TOP OF FOOTING:
 MAX. DEPTH BELOW AVERAGE SIDEWALK = 1.73
 LOWEST ELEVATION = 965.28

AS-BUILT SEWER INVERT ELEVATIONS:
 SANITARY AT 5.0m INSIDE LOT = 964.43
 STORM AT 5.0m INSIDE LOT = 964.43

CIVIC ADDRESS: 14 VANVELLER WAY
 LOT: 17 BLOCK: 2 PLAN No.: 132 5350
 DEVELOPER: WHITECAP COMMUNITIES INC SCALE: 1:500
 DRAWN BY: STANTEC CONSULTING LTD DATE: MAY 24, 2013
 APPROVED BY: C.G., P. ENG DATE: -
 RECEIVED BY: DATE:


DESIGN LANDSCAPE ELEVATIONS
 ELEV. AT FRONT OF HOUSE = 967.66
 ELEV. AT REAR OF HOUSE = 966.32

I CERTIFY THAT THE FINAL LANDSCAPE GRADE WILL BE (FRONT) _____
 (REAR) _____
 SIGNATURE OF OWNER OR REPRESENTATIVE _____


BUILDING GRADE CERTIFICATE

Town of Sylvan Lake
 Issued by: No.

1. WHEN EXCAVATING IN A RIGHT OF WAY (EASEMENT), CHECK FOR UTILITIES.
2. STANDING AT THE WATER SHUTOFF AND FACING THE BUILDING, THE SANITARY SERVICE (PAINTED RED) IS ON THE LEFT SIDE OF THE WATER SERVICE; STORM SERVICE (PAINTED GREEN) IS ON THE RIGHT SIDE OF THE WATER SERVICE.
3. ALL DIMENSIONS ARE IN METRES AND DECIMALS THERE OF. THE ELEVATIONS ARE IN METRES ABOVE GEODETIC MEAN SEA LEVEL.
4. ELEVATIONS NOTED ON THE CERTIFICATE ARE WITHIN 100mm OF ACTUAL.
5. THE BUILDER MUST CONSTRUCT WITHIN 100mm OF THE DESIGN LANDSCAPE ELEVATION & ILLUSTRATED DRAINAGE PATTERNS UNLESS OTHERWISE APPROVED BY THE DEVELOPMENT OFFICER.
6. IF THE INFORMATION ON THIS CERTIFICATE HAS BEEN PREPARED BY A PRIVATE DEVELOPER OR THEIR AGENT, THE TOWN OF SYLVAN LAKE ACCEPTS NO RESPONSIBILITY FOR ITS ACCURACY.

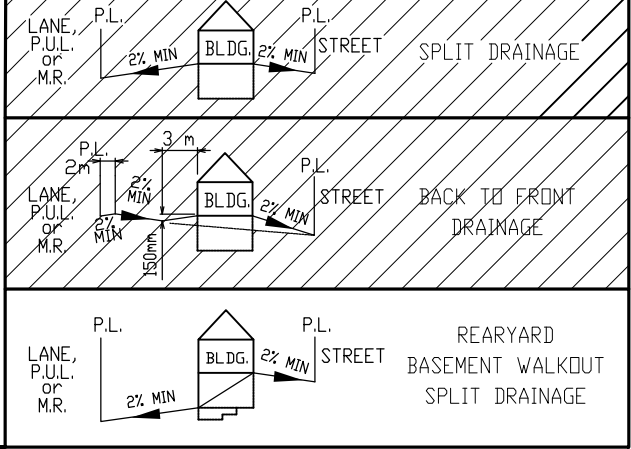

- LEGEND**
- SAN, WATER & STORM
 - ⊙ FIRE HYDRANT
 - - - GAS
 - ☀ POWER, TELEPHONE & CABLE SERVICE
 - ⊙ STREET LIGHT
 - ⊠ COMMUNITY MAILBOX
 - TRANSFORMER
 - EL&P TRANSFORMER
 - SHAW PEDESTAL
 - ▲ TELEPHONE PEDESTAL
 - URD BOX

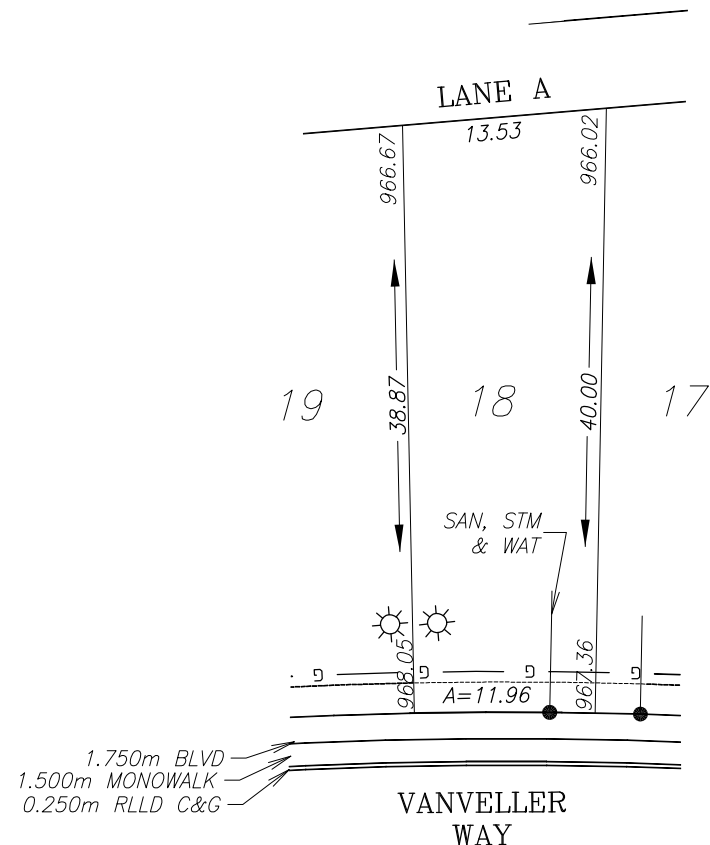




WATER, SANITARY AND STORM SERVICE LOCATION IS 3.0m FROM LOTLINE

TOP OF FOOTING: MAX. DEPTH BELOW AVERAGE SIDEWALK = <u>2.08</u> LOWEST ELEVATION = <u>965.63</u>	CIVIC ADDRESS: <u>16 VANVELLER WAY</u> LOT: <u>18</u> BLOCK: <u>2</u> PLAN No.: <u>132 5350</u> DEVELOPER: <u>WHITECAP COMMUNITIES INC</u> SCALE: <u>1:500</u> DRAWN BY: <u>STANTEC CONSULTING LTD</u> DATE: <u>MAY 24, 2013</u> APPROVED BY: <u>C.G., P. ENG</u> DATE: <u>-</u> RECEIVED BY: _____ DATE: _____
AS-BUILT SEWER INVERT ELEVATIONS: SANITARY AT 5.0m INSIDE LOT = <u>964.78</u> STORM AT 5.0m INSIDE LOT = <u>964.78</u>	
DESIGN LANDSCAPE ELEVATIONS ELEV. AT FRONT OF HOUSE = <u>968.35</u> ELEV. AT REAR OF HOUSE = <u>966.97</u>	I CERTIFY THAT THE FINAL LANDSCAPE GRADE WILL BE (FRONT) _____ (REAR) _____ SIGNATURE OF OWNER OR REPRESENTATIVE _____


BUILDING GRADE CERTIFICATE

Town of Sylvan Lake
 Issued by: No.

1. WHEN EXCAVATING IN A RIGHT OF WAY (EASEMENT), CHECK FOR UTILITIES.
2. STANDING AT THE WATER SHUTOFF AND FACING THE BUILDING, THE SANITARY SERVICE (PAINTED RED) IS ON THE LEFT SIDE OF THE WATER SERVICE; STORM SERVICE (PAINTED GREEN) IS ON THE RIGHT SIDE OF THE WATER SERVICE.
3. ALL DIMENSIONS ARE IN METRES AND DECIMALS THERE OF. THE ELEVATIONS ARE IN METRES ABOVE GEODETIC MEAN SEA LEVEL.
4. ELEVATIONS NOTED ON THE CERTIFICATE ARE WITHIN 100mm OF ACTUAL.
5. THE BUILDER MUST CONSTRUCT WITHIN 100mm OF THE DESIGN LANDSCAPE ELEVATION & ILLUSTRATED DRAINAGE PATTERNS UNLESS OTHERWISE APPROVED BY THE DEVELOPMENT OFFICER.
6. IF THE INFORMATION ON THIS CERTIFICATE HAS BEEN PREPARED BY A PRIVATE DEVELOPER OR THEIR AGENT, THE TOWN OF SYLVAN LAKE ACCEPTS NO RESPONSIBILITY FOR ITS ACCURACY.

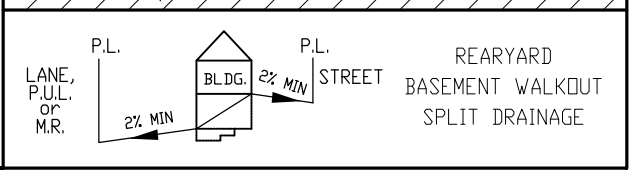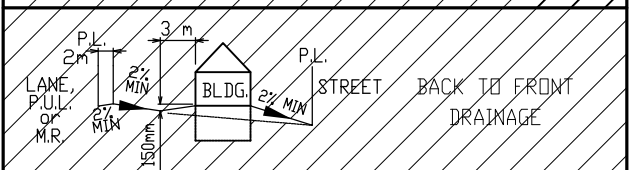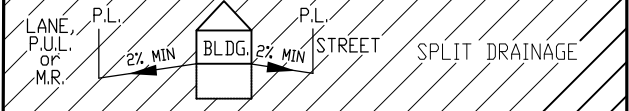

- LEGEND**
- SAN, WATER & STORM
 - ⊙ FIRE HYDRANT
 - - - GAS
 - ☀ POWER, TELEPHONE & CABLE SERVICE
 - STREET LIGHT
 - ⊠ COMMUNITY MAILBOX
 - TRANSFORMER
 - EL&P TRANSFORMER
 - SHAW PEDESTAL
 - ▲ TELEPHONE PEDESTAL
 - URD BOX

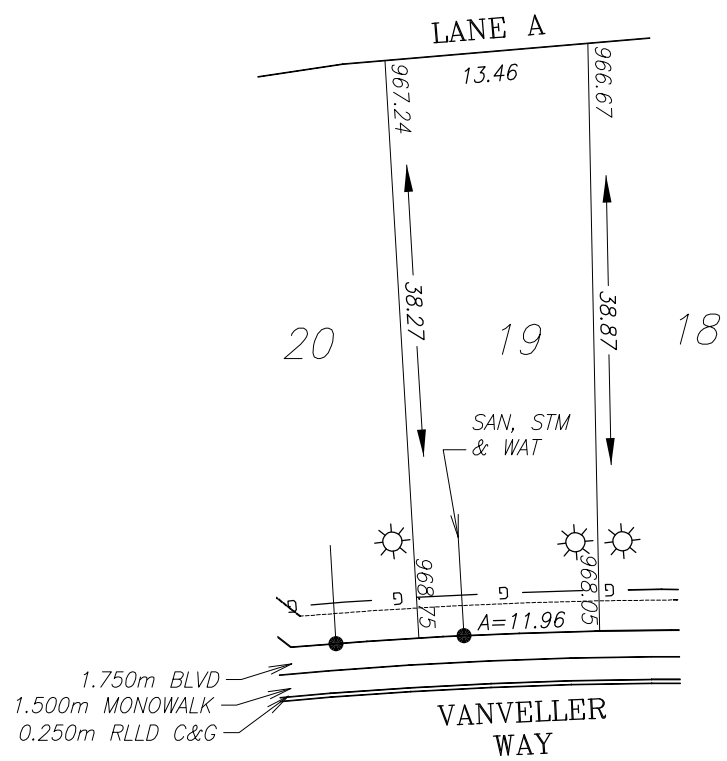

WATER, SANITARY AND STORM SERVICE LOCATION IS 3.0m FROM LOTLINE

TOP OF FOOTING:
 MAX. DEPTH BELOW AVERAGE SIDEWALK = 1.72
 LOWEST ELEVATION = 966.68

AS-BUILT SEWER INVERT ELEVATIONS:
 SANITARY AT 5.0m INSIDE LOT = 965.83
 STORM AT 5.0m INSIDE LOT = 965.83

CIVIC ADDRESS: 18 VANVELLER WAY
 LOT: 19 BLOCK: 2 PLAN No.: 132 5350
 DEVELOPER: WHITECAP COMMUNITIES INC SCALE: 1:500
 DRAWN BY: STANTEC CONSULTING LTD DATE: MAY 24, 2013
 APPROVED BY: C.G., P. ENG DATE: -
 RECEIVED BY: DATE: -



DESIGN LANDSCAPE ELEVATIONS
 ELEV. AT FRONT OF HOUSE = 969.05
 ELEV. AT REAR OF HOUSE = 967.54

I CERTIFY THAT THE FINAL LANDSCAPE GRADE WILL BE (FRONT) _____
 (REAR) _____
 SIGNATURE OF OWNER OR REPRESENTATIVE _____

BUILDING GRADE CERTIFICATE

Town of Sylvan Lake
 Issued by: _____ No. _____

1. WHEN EXCAVATING IN A RIGHT OF WAY (EASEMENT), CHECK FOR UTILITIES.
2. STANDING AT THE WATER SHUTOFF AND FACING THE BUILDING, THE SANITARY SERVICE (PAINTED RED) IS ON THE LEFT SIDE OF THE WATER SERVICE; STORM SERVICE (PAINTED GREEN) IS ON THE RIGHT SIDE OF THE WATER SERVICE.
3. ALL DIMENSIONS ARE IN METRES AND DECIMALS THERE OF. THE ELEVATIONS ARE IN METRES ABOVE GEODETIC MEAN SEA LEVEL.
4. ELEVATIONS NOTED ON THE CERTIFICATE ARE WITHIN 100mm OF ACTUAL.
5. THE BUILDER MUST CONSTRUCT WITHIN 100mm OF THE DESIGN LANDSCAPE ELEVATION & ILLUSTRATED DRAINAGE PATTERNS UNLESS OTHERWISE APPROVED BY THE DEVELOPMENT OFFICER.
6. IF THE INFORMATION ON THIS CERTIFICATE HAS BEEN PREPARED BY A PRIVATE DEVELOPER OR THEIR AGENT, THE TOWN OF SYLVAN LAKE ACCEPTS NO RESPONSIBILITY FOR ITS ACCURACY.

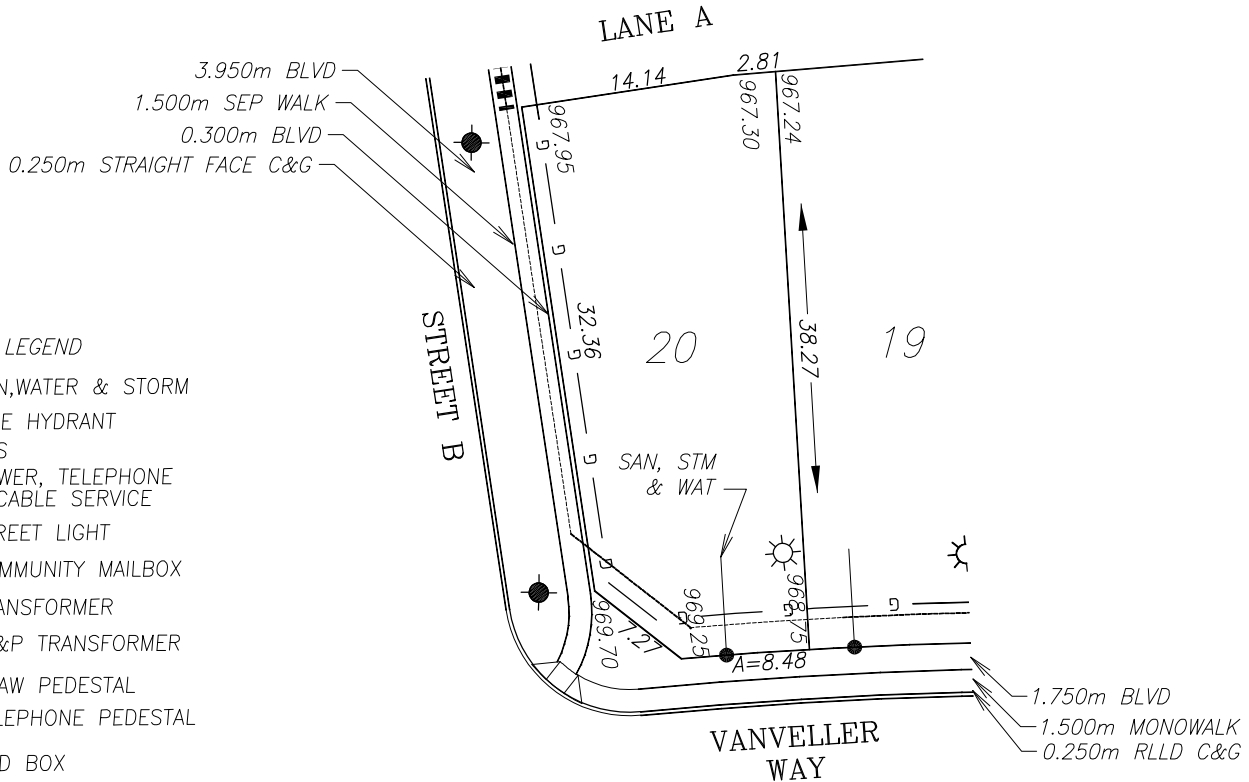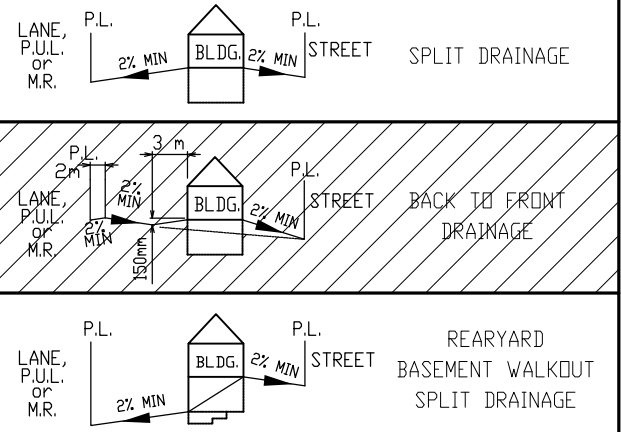

WATER, SANITARY AND STORM SERVICE LOCATION IS 5.5m FROM LOTLINE

TOP OF FOOTING: MAX. DEPTH BELOW AVERAGE SIDEWALK = <u>1.83</u> LOWEST ELEVATION = <u>967.17</u>	CIVIC ADDRESS: <u>20 VANVELLER WAY</u> LOT: <u>20</u> BLOCK: <u>2</u> PLAN No.: <u>132 5350</u> DEVELOPER: <u>WHITECAP COMMUNITIES INC</u> SCALE: <u>1:500</u> DRAWN BY: <u>STANTEC CONSULTING LTD</u> DATE: <u>MAY 24, 2013</u> APPROVED BY: <u>C.G., P. ENG</u> DATE: <u>-</u> RECEIVED BY: _____ DATE: _____
AS-BUILT SEWER INVERT ELEVATIONS: SANITARY AT 5.0m INSIDE LOT = <u>966.32</u> STORM AT 5.0m INSIDE LOT = <u>966.32</u>	




DESIGN LANDSCAPE ELEVATIONS
 ELEV. AT FRONT OF HOUSE = 970.00
 ELEV. AT REAR OF HOUSE = 968.25

I CERTIFY THAT THE FINAL LANDSCAPE GRADE WILL BE (FRONT) _____ (REAR) _____
 SIGNATURE OF OWNER OR REPRESENTATIVE _____

BUILDING GRADE CERTIFICATE

Town of Sylvan Lake
 Issued by: No.

1. WHEN EXCAVATING IN A RIGHT OF WAY (EASEMENT), CHECK FOR UTILITIES.
2. STANDING AT THE WATER SHUTOFF AND FACING THE BUILDING, THE SANITARY SERVICE (PAINTED RED) IS ON THE LEFT SIDE OF THE WATER SERVICE; STORM SERVICE (PAINTED GREEN) IS ON THE RIGHT SIDE OF THE WATER SERVICE.
3. ALL DIMENSIONS ARE IN METRES AND DECIMALS THERE OF. THE ELEVATIONS ARE IN METRES ABOVE GEODETIC MEAN SEA LEVEL.
4. ELEVATIONS NOTED ON THE CERTIFICATE ARE WITHIN 100mm OF ACTUAL.
5. THE BUILDER MUST CONSTRUCT WITHIN 100mm OF THE DESIGN LANDSCAPE ELEVATION & ILLUSTRATED DRAINAGE PATTERNS UNLESS OTHERWISE APPROVED BY THE DEVELOPMENT OFFICER.
6. IF THE INFORMATION ON THIS CERTIFICATE HAS BEEN PREPARED BY A PRIVATE DEVELOPER OR THEIR AGENT, THE TOWN OF SYLVAN LAKE ACCEPTS NO RESPONSIBILITY FOR ITS ACCURACY.

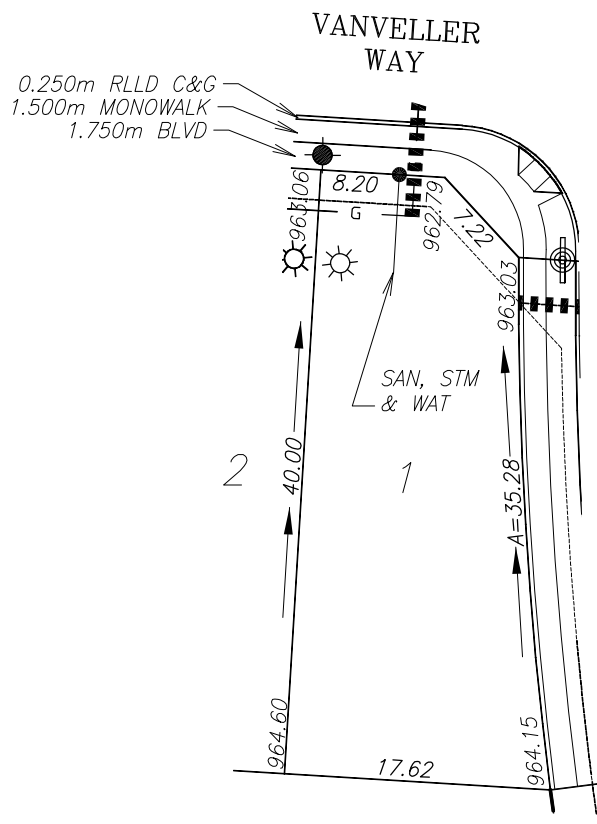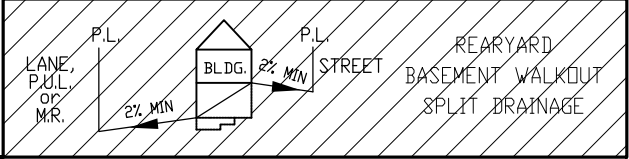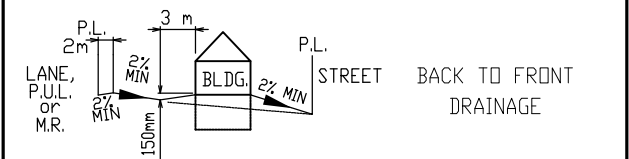

LEGEND

- SAN, WATER & STORM
- ⊙ FIRE HYDRANT
- - - GAS
- ☀ POWER, TELEPHONE & CABLE SERVICE
- STREET LIGHT
- ⊠ COMMUNITY MAILBOX
- TRANSFORMER
- EL&P TRANSFORMER
- SHAW PEDESTAL
- ▲ TELEPHONE PEDESTAL
- URD BOX

WATER, SANITARY AND STORM SERVICE LOCATION IS 5.2m FROM LOTLINE

TOP OF FOOTING:
 MAX. DEPTH BELOW AVERAGE SIDEWALK = 1.95
 LOWEST ELEVATION = 960.98

AS-BUILT SEWER INVERT ELEVATIONS:
 SANITARY AT 5.0m INSIDE LOT = 960.13
 STORM AT 5.0m INSIDE LOT = 960.46

CIVIC ADDRESS: 1 VANVELLER WAY
 LOT: 1 BLOCK: 3 PLAN No.: 132 5350
 DEVELOPER: WHITECAP COMMUNITIES INC SCALE: 1:500
 DRAWN BY: STANTEC CONSULTING LTD DATE: MAY 24, 2013
 APPROVED BY: C.G., P. ENG DATE: -
 RECEIVED BY: DATE:




DESIGN LANDSCAPE ELEVATIONS
 ELEV. AT FRONT OF HOUSE = 963.36
 ELEV. AT REAR OF HOUSE = 965.05

I CERTIFY THAT THE FINAL LANDSCAPE GRADE WILL BE (FRONT) _____
 (REAR) _____
 SIGNATURE OF OWNER OR REPRESENTATIVE _____

BUILDING GRADE CERTIFICATE

Town of Sylvan Lake
 Issued by: No.

1. WHEN EXCAVATING IN A RIGHT OF WAY (EASEMENT), CHECK FOR UTILITIES.
2. STANDING AT THE WATER SHUTOFF AND FACING THE BUILDING, THE SANITARY SERVICE (PAINTED RED) IS ON THE LEFT SIDE OF THE WATER SERVICE; STORM SERVICE (PAINTED GREEN) IS ON THE RIGHT SIDE OF THE WATER SERVICE.
3. ALL DIMENSIONS ARE IN METRES AND DECIMALS THERE OF. THE ELEVATIONS ARE IN METRES ABOVE GEODETIC MEAN SEA LEVEL.
4. ELEVATIONS NOTED ON THE CERTIFICATE ARE WITHIN 100mm OF ACTUAL.
5. THE BUILDER MUST CONSTRUCT WITHIN 100mm OF THE DESIGN LANDSCAPE ELEVATION & ILLUSTRATED DRAINAGE PATTERNS UNLESS OTHERWISE APPROVED BY THE DEVELOPMENT OFFICER.
6. IF THE INFORMATION ON THIS CERTIFICATE HAS BEEN PREPARED BY A PRIVATE DEVELOPER OR THEIR AGENT, THE TOWN OF SYLVAN LAKE ACCEPTS NO RESPONSIBILITY FOR ITS ACCURACY.

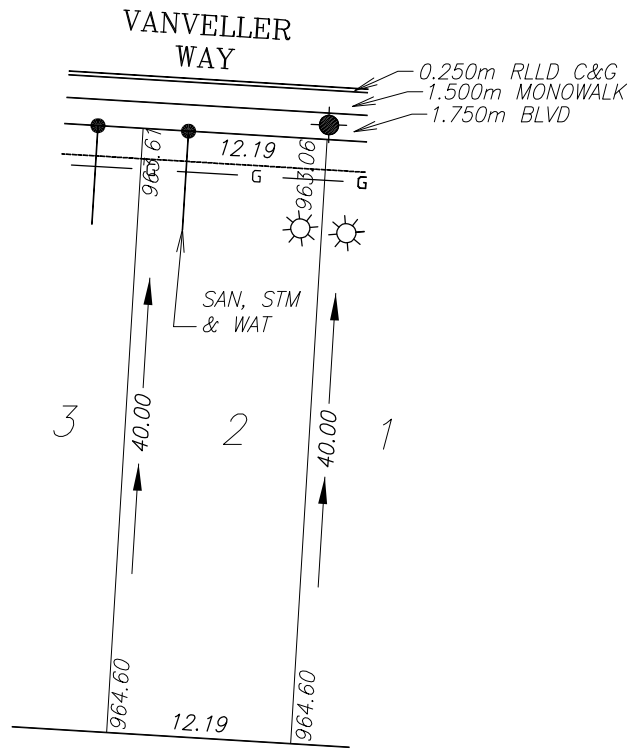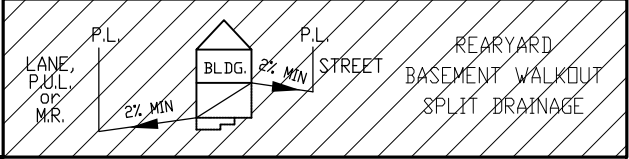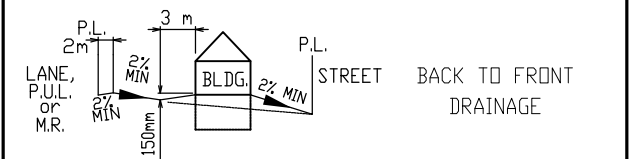

LEGEND

- SAN, WATER & STORM
- ⊙ FIRE HYDRANT
- - - GAS
- ☀ POWER, TELEPHONE & CABLE SERVICE
- STREET LIGHT
- ⊠ COMMUNITY MAILBOX
- TRANSFORMER
- EL&P TRANSFORMER
- SHAW PEDESTAL
- ▲ TELEPHONE PEDESTAL
- URD BOX

WATER, SANITARY AND STORM SERVICE LOCATION IS 3.0m FROM LOTLINE

TOP OF FOOTING:
 MAX. DEPTH BELOW AVERAGE SIDEWALK = 1.79
 LOWEST ELEVATION = 961.55

AS-BUILT SEWER INVERT ELEVATIONS:
 SANITARY AT 5.0m INSIDE LOT = 960.66
 STORM AT 5.0m INSIDE LOT = 960.89

CIVIC ADDRESS: 3 VANVELLER WAY
 LOT: 2 BLOCK: 3 PLAN No.: 132 5350
 DEVELOPER: WHITECAP COMMUNITIES INC SCALE: 1:500
 DRAWN BY: STANTEC CONSULTING LTD DATE: MAY 24, 2013
 APPROVED BY: C.G., P. ENG DATE: -
 RECEIVED BY: DATE:





DESIGN LANDSCAPE ELEVATIONS
 ELEV. AT FRONT OF HOUSE = 963.91
 ELEV. AT REAR OF HOUSE = 965.05

I CERTIFY THAT THE FINAL LANDSCAPE GRADE WILL BE (FRONT) _____
 (REAR) _____
 SIGNATURE OF OWNER OR REPRESENTATIVE _____

BUILDING GRADE CERTIFICATE

Town of Sylvan Lake
 Issued by: _____ No. _____

1. WHEN EXCAVATING IN A RIGHT OF WAY (EASEMENT), CHECK FOR UTILITIES.
2. STANDING AT THE WATER SHUTOFF AND FACING THE BUILDING, THE SANITARY SERVICE (PAINTED RED) IS ON THE LEFT SIDE OF THE WATER SERVICE; STORM SERVICE (PAINTED GREEN) IS ON THE RIGHT SIDE OF THE WATER SERVICE.
3. ALL DIMENSIONS ARE IN METRES AND DECIMALS THERE OF. THE ELEVATIONS ARE IN METRES ABOVE GEODETIC MEAN SEA LEVEL.
4. ELEVATIONS NOTED ON THE CERTIFICATE ARE WITHIN 100mm OF ACTUAL.
5. THE BUILDER MUST CONSTRUCT WITHIN 100mm OF THE DESIGN LANDSCAPE ELEVATION & ILLUSTRATED DRAINAGE PATTERNS UNLESS OTHERWISE APPROVED BY THE DEVELOPMENT OFFICER.
6. IF THE INFORMATION ON THIS CERTIFICATE HAS BEEN PREPARED BY A PRIVATE DEVELOPER OR THEIR AGENT, THE TOWN OF SYLVAN LAKE ACCEPTS NO RESPONSIBILITY FOR ITS ACCURACY.

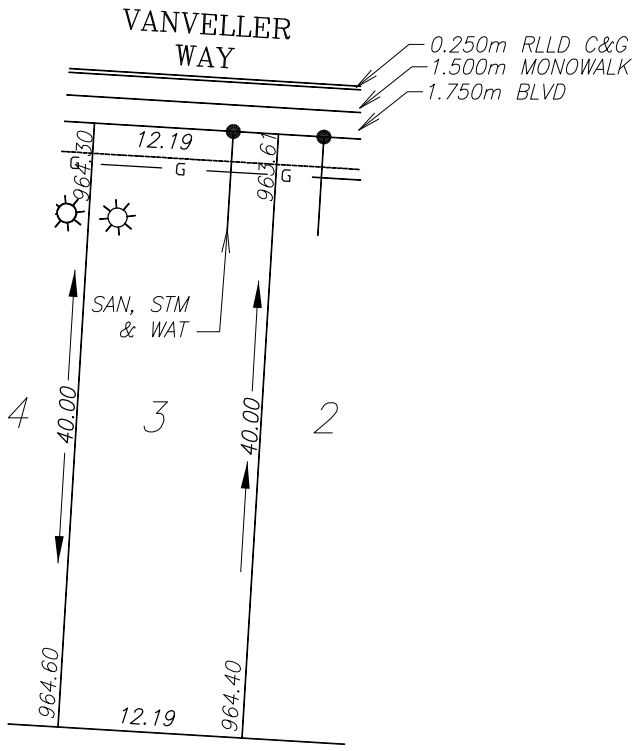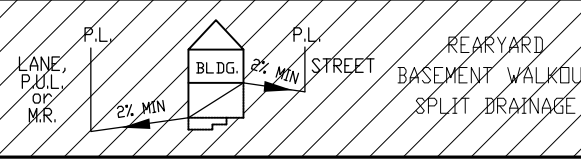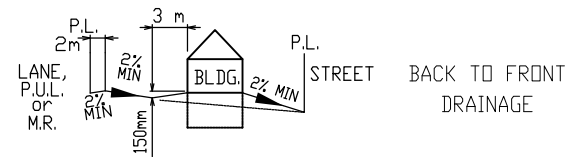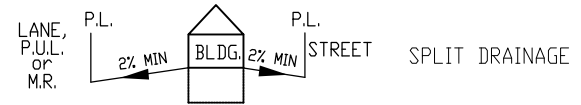

LEGEND

- SAN, WATER & STORM
- ☉ FIRE HYDRANT
- - - GAS
- ☀ POWER, TELEPHONE & CABLE SERVICE
- ☼ STREET LIGHT
- ☒ COMMUNITY MAILBOX
- TRANSFORMER
- EL&P TRANSFORMER
- SHAW PEDESTAL
- ▲ TELEPHONE PEDESTAL
- URD BOX

WATER, SANITARY AND STORM SERVICE LOCATION IS 3.0m FROM LOTLINE

TOP OF FOOTING:
 MAX. DEPTH BELOW AVERAGE SIDEWALK = 2.09
 LOWEST ELEVATION = 961.87

AS-BUILT SEWER INVERT ELEVATIONS:
 SANITARY AT 5.0m INSIDE LOT = 960.02
 STORM AT 5.0m INSIDE LOT = 960.04

CIVIC ADDRESS: 5 VANVELLER WAY
 LOT: 3 BLOCK: 3 PLAN No.: 132 5350
 DEVELOPER: WHITECAP COMMUNITIES INC SCALE: 1:500
 DRAWN BY: STANTEC CONSULTING LTD DATE: MAY 24, 2013
 APPROVED BY: C.G., P. ENG DATE: -
 RECEIVED BY: _____ DATE: _____



DESIGN LANDSCAPE ELEVATIONS
 ELEV. AT FRONT OF HOUSE = 964.60
 ELEV. AT REAR OF HOUSE = 965.05

I CERTIFY THAT THE FINAL LANDSCAPE GRADE WILL BE (FRONT) _____
 (REAR) _____
 SIGNATURE OF OWNER OR REPRESENTATIVE _____

BUILDING GRADE CERTIFICATE

Town of Sylvan Lake
 Issued by: No.

1. WHEN EXCAVATING IN A RIGHT OF WAY (EASEMENT), CHECK FOR UTILITIES.
2. STANDING AT THE WATER SHUTOFF AND FACING THE BUILDING, THE SANITARY SERVICE (PAINTED RED) IS ON THE LEFT SIDE OF THE WATER SERVICE; STORM SERVICE (PAINTED GREEN) IS ON THE RIGHT SIDE OF THE WATER SERVICE.
3. ALL DIMENSIONS ARE IN METRES AND DECIMALS THERE OF. THE ELEVATIONS ARE IN METRES ABOVE GEODETIC MEAN SEA LEVEL.
4. ELEVATIONS NOTED ON THE CERTIFICATE ARE WITHIN 100mm OF ACTUAL.
5. THE BUILDER MUST CONSTRUCT WITHIN 100mm OF THE DESIGN LANDSCAPE ELEVATION & ILLUSTRATED DRAINAGE PATTERNS UNLESS OTHERWISE APPROVED BY THE DEVELOPMENT OFFICER.
6. IF THE INFORMATION ON THIS CERTIFICATE HAS BEEN PREPARED BY A PRIVATE DEVELOPER OR THEIR AGENT, THE TOWN OF SYLVAN LAKE ACCEPTS NO RESPONSIBILITY FOR ITS ACCURACY.

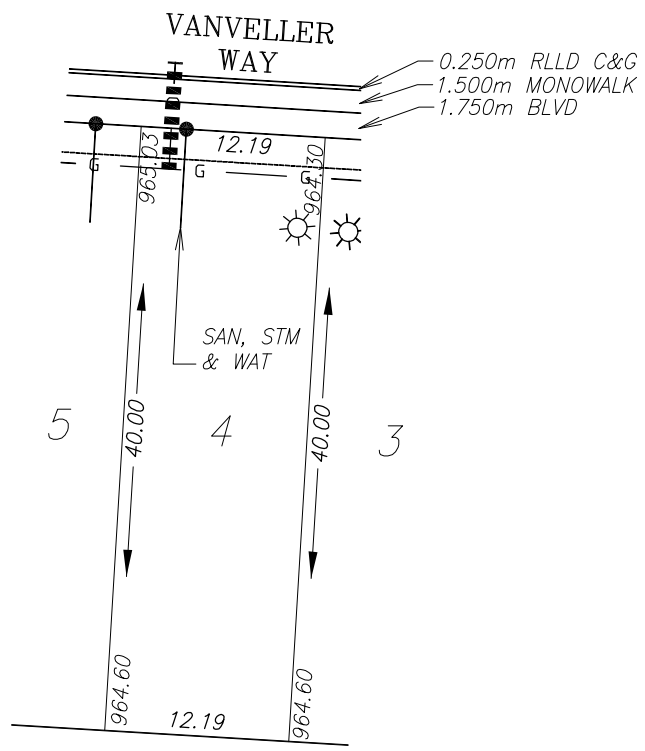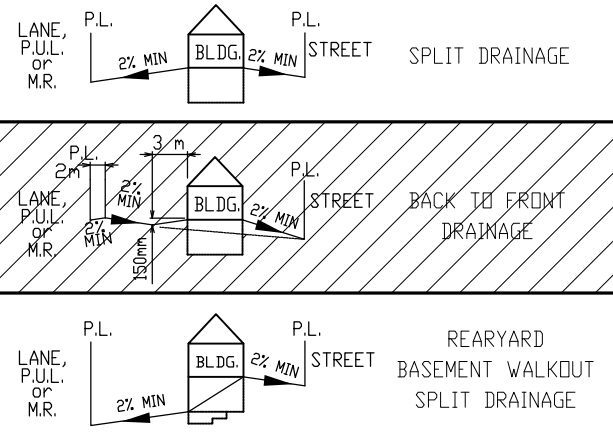

LEGEND

- SAN, WATER & STORM
- ⊙ FIRE HYDRANT
- - - GAS
- ☀ POWER, TELEPHONE & CABLE SERVICE
- STREET LIGHT
- ⊠ COMMUNITY MAILBOX
- TRANSFORMER
- EL&P TRANSFORMER
- SHAW PEDESTAL
- ▲ TELEPHONE PEDESTAL
- URD BOX

WATER, SANITARY AND STORM SERVICE LOCATION IS 3.0m FROM LOTLINE

TOP OF FOOTING:
 MAX. DEPTH BELOW AVERAGE SIDEWALK = 1.72
 LOWEST ELEVATION = 962.95

AS-BUILT SEWER INVERT ELEVATIONS:
 SANITARY AT 5.0m INSIDE LOT = 962.10
 STORM AT 5.0m INSIDE LOT = 962.10

CIVIC ADDRESS: 7 VANVELLER WAY
 LOT: 4 BLOCK: 3 PLAN No.: 132 5350
 DEVELOPER: WHITECAP COMMUNITIES INC SCALE: 1:500
 DRAWN BY: STANTEC CONSULTING LTD DATE: MAY 24, 2013
 APPROVED BY: C.G., P. ENG DATE: -
 RECEIVED BY: DATE:



DESIGN LANDSCAPE ELEVATIONS
 ELEV. AT FRONT OF HOUSE = 965.33
 ELEV. AT REAR OF HOUSE = 965.05

I CERTIFY THAT THE FINAL LANDSCAPE GRADE WILL BE (FRONT) _____
 (REAR) _____
 SIGNATURE OF OWNER OR REPRESENTATIVE _____

BUILDING GRADE CERTIFICATE

Town of Sylvan Lake
 Issued by: No.

1. WHEN EXCAVATING IN A RIGHT OF WAY (EASEMENT), CHECK FOR UTILITIES.
2. STANDING AT THE WATER SHUTOFF AND FACING THE BUILDING, THE SANITARY SERVICE (PAINTED RED) IS ON THE LEFT SIDE OF THE WATER SERVICE; STORM SERVICE (PAINTED GREEN) IS ON THE RIGHT SIDE OF THE WATER SERVICE.
3. ALL DIMENSIONS ARE IN METRES AND DECIMALS THERE OF. THE ELEVATIONS ARE IN METRES ABOVE GEODETIC MEAN SEA LEVEL.
4. ELEVATIONS NOTED ON THE CERTIFICATE ARE WITHIN 100mm OF ACTUAL.
5. THE BUILDER MUST CONSTRUCT WITHIN 100mm OF THE DESIGN LANDSCAPE ELEVATION & ILLUSTRATED DRAINAGE PATTERNS UNLESS OTHERWISE APPROVED BY THE DEVELOPMENT OFFICER.
6. IF THE INFORMATION ON THIS CERTIFICATE HAS BEEN PREPARED BY A PRIVATE DEVELOPER OR THEIR AGENT, THE TOWN OF SYLVAN LAKE ACCEPTS NO RESPONSIBILITY FOR ITS ACCURACY.

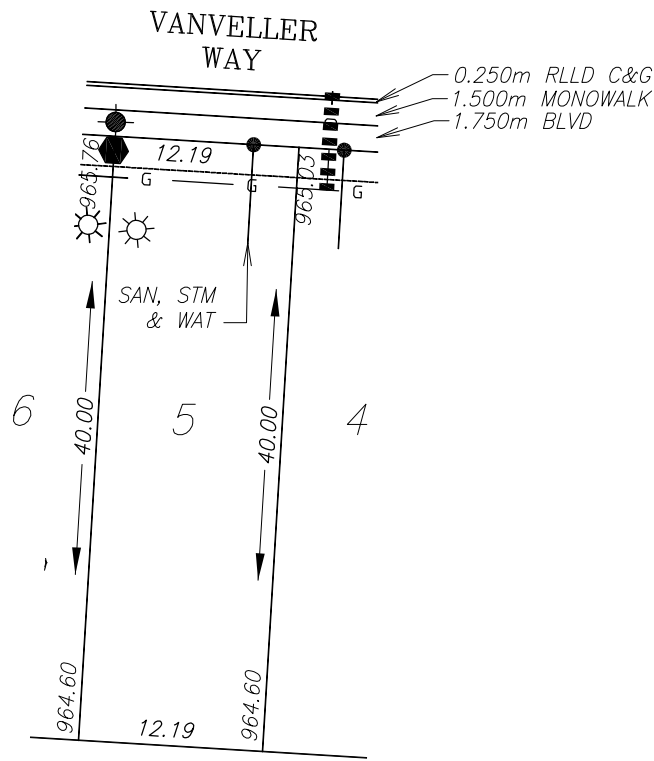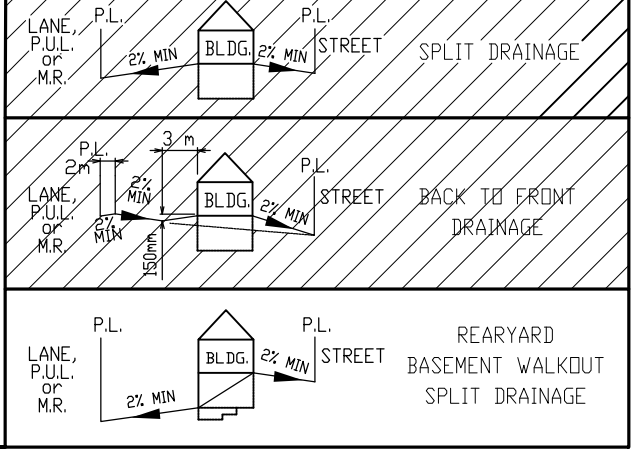

LEGEND

- SAN, WATER & STORM
- ☉ FIRE HYDRANT
- - - GAS
- ☀ POWER, TELEPHONE & CABLE SERVICE
- STREET LIGHT
- ☒ COMMUNITY MAILBOX
- TRANSFORMER
- EL&P TRANSFORMER
- SHAW PEDESTAL
- ▲ TELEPHONE PEDESTAL
- URD BOX



WATER, SANITARY AND STORM SERVICE LOCATION IS 3.0m FROM LOTLINE

TOP OF FOOTING: MAX. DEPTH BELOW AVERAGE SIDEWALK = <u>2.09</u> LOWEST ELEVATION = <u>963.31</u>	CIVIC ADDRESS: <u>9 VANVELLER WAY</u> LOT: <u>5</u> BLOCK: <u>3</u> PLAN No.: <u>132 5350</u> DEVELOPER: <u>WHITECAP COMMUNITIES INC</u> SCALE: <u>1:500</u> DRAWN BY: <u>STANTEC CONSULTING LTD</u> DATE: <u>MAY 24, 2013</u> APPROVED BY: <u>C.G., P. ENG</u> DATE: <u>-</u> RECEIVED BY: _____ DATE: _____
AS-BUILT SEWER INVERT ELEVATIONS: SANITARY AT 5.0m INSIDE LOT = <u>962.46</u> STORM AT 5.0m INSIDE LOT = <u>962.46</u>	DESIGN LANDSCAPE ELEVATIONS ELEV. AT FRONT OF HOUSE = <u>966.06</u> ELEV. AT REAR OF HOUSE = <u>965.05</u>
I CERTIFY THAT THE FINAL LANDSCAPE GRADE WILL BE (FRONT) _____ (REAR) _____ SIGNATURE OF OWNER OR REPRESENTATIVE _____	

BUILDING GRADE CERTIFICATE

Town of Sylvan Lake
 Issued by: No.

1. WHEN EXCAVATING IN A RIGHT OF WAY (EASEMENT), CHECK FOR UTILITIES.
2. STANDING AT THE WATER SHUTOFF AND FACING THE BUILDING, THE SANITARY SERVICE (PAINTED RED) IS ON THE LEFT SIDE OF THE WATER SERVICE; STORM SERVICE (PAINTED GREEN) IS ON THE RIGHT SIDE OF THE WATER SERVICE.
3. ALL DIMENSIONS ARE IN METRES AND DECIMALS THERE OF. THE ELEVATIONS ARE IN METRES ABOVE GEODETIC MEAN SEA LEVEL.
4. ELEVATIONS NOTED ON THE CERTIFICATE ARE WITHIN 100mm OF ACTUAL.
5. THE BUILDER MUST CONSTRUCT WITHIN 100mm OF THE DESIGN LANDSCAPE ELEVATION & ILLUSTRATED DRAINAGE PATTERNS UNLESS OTHERWISE APPROVED BY THE DEVELOPMENT OFFICER.
6. IF THE INFORMATION ON THIS CERTIFICATE HAS BEEN PREPARED BY A PRIVATE DEVELOPER OR THEIR AGENT, THE TOWN OF SYLVAN LAKE ACCEPTS NO RESPONSIBILITY FOR ITS ACCURACY.

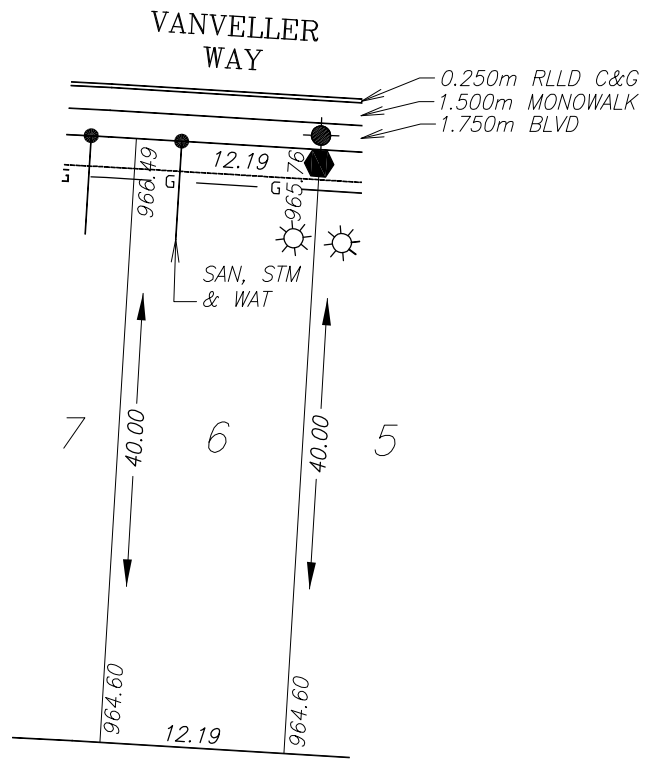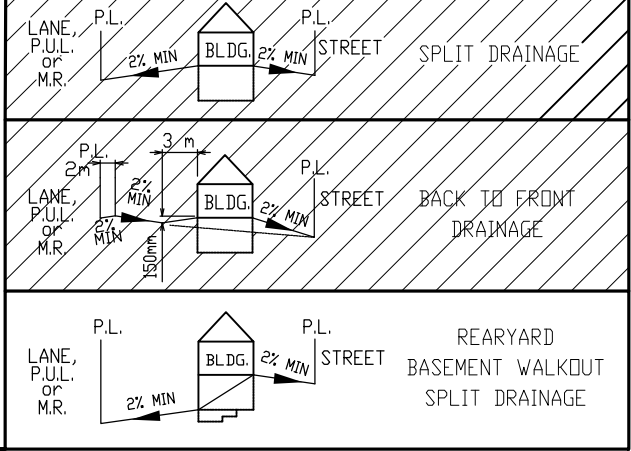

LEGEND

- SAN, WATER & STORM
- ⊙ FIRE HYDRANT
- - - GAS
- ☀ POWER, TELEPHONE & CABLE SERVICE
- STREET LIGHT
- ⊠ COMMUNITY MAILBOX
- TRANSFORMER
- EL&P TRANSFORMER
- SHAW PEDESTAL
- ▲ TELEPHONE PEDESTAL
- URD BOX





WATER, SANITARY AND STORM SERVICE LOCATION IS 3.0m FROM LOTLINE

TOP OF FOOTING: MAX. DEPTH BELOW AVERAGE SIDEWALK = <u>1.72</u> LOWEST ELEVATION = <u>964.41</u>	CIVIC ADDRESS: <u>11 VANVELLER WAY</u> LOT: <u>6</u> BLOCK: <u>3</u> PLAN No.: <u>132 5350</u> DEVELOPER: <u>WHITECAP COMMUNITIES INC</u> SCALE: <u>1:500</u> DRAWN BY: <u>STANTEC CONSULTING LTD</u> DATE: <u>MAY 24, 2013</u> APPROVED BY: <u>C.G., P. ENG</u> DATE: <u>-</u> RECEIVED BY: _____ DATE: _____
AS-BUILT SEWER INVERT ELEVATIONS: SANITARY AT 5.0m INSIDE LOT = <u>963.56</u> STORM AT 5.0m INSIDE LOT = <u>963.56</u>	I CERTIFY THAT THE FINAL LANDSCAPE GRADE WILL BE (FRONT) _____ (REAR) _____ SIGNATURE OF OWNER OR REPRESENTATIVE _____
DESIGN LANDSCAPE ELEVATIONS ELEV. AT FRONT OF HOUSE = <u>966.79</u> ELEV. AT REAR OF HOUSE = <u>964.95</u>	

BUILDING GRADE CERTIFICATE

Town of Sylvan Lake
 Issued by: _____ No. _____

1. WHEN EXCAVATING IN A RIGHT OF WAY (EASEMENT), CHECK FOR UTILITIES.
2. STANDING AT THE WATER SHUTOFF AND FACING THE BUILDING, THE SANITARY SERVICE (PAINTED RED) IS ON THE LEFT SIDE OF THE WATER SERVICE; STORM SERVICE (PAINTED GREEN) IS ON THE RIGHT SIDE OF THE WATER SERVICE.
3. ALL DIMENSIONS ARE IN METRES AND DECIMALS THERE OF. THE ELEVATIONS ARE IN METRES ABOVE GEODETIC MEAN SEA LEVEL.
4. ELEVATIONS NOTED ON THE CERTIFICATE ARE WITHIN 100mm OF ACTUAL.
5. THE BUILDER MUST CONSTRUCT WITHIN 100mm OF THE DESIGN LANDSCAPE ELEVATION & ILLUSTRATED DRAINAGE PATTERNS UNLESS OTHERWISE APPROVED BY THE DEVELOPMENT OFFICER.
6. IF THE INFORMATION ON THIS CERTIFICATE HAS BEEN PREPARED BY A PRIVATE DEVELOPER OR THEIR AGENT, THE TOWN OF SYLVAN LAKE ACCEPTS NO RESPONSIBILITY FOR ITS ACCURACY.

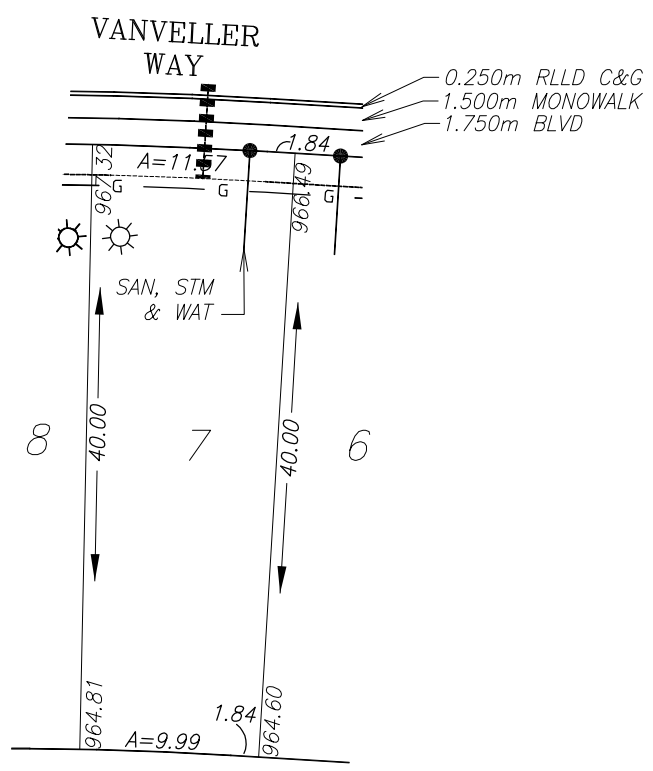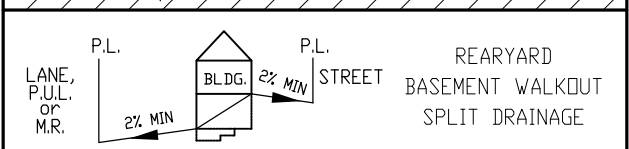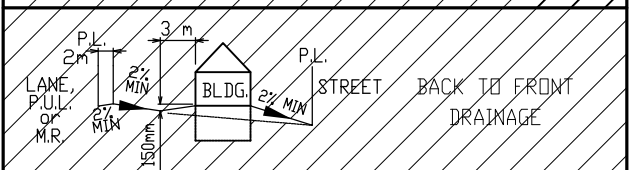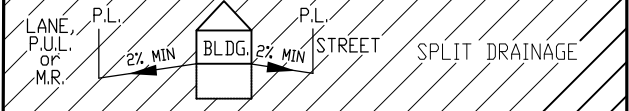

LEGEND

- SAN, WATER & STORM
- ☉ FIRE HYDRANT
- - - GAS
- ☀ POWER, TELEPHONE & CABLE SERVICE
- STREET LIGHT
- ☒ COMMUNITY MAILBOX
- TRANSFORMER
- EL&P TRANSFORMER
- SHAW PEDESTAL
- ▲ TELEPHONE PEDESTAL
- URD BOX


WATER, SANITARY AND STORM SERVICE LOCATION IS 3.0m FROM LOTLINE

TOP OF FOOTING: MAX. DEPTH BELOW AVERAGE SIDEWALK = <u>2.14</u> LOWEST ELEVATION = <u>964.77</u>	CIVIC ADDRESS: <u>13 VANVELLER WAY</u> LOT: <u>7</u> BLOCK: <u>3</u> PLAN No.: <u>132 5350</u> DEVELOPER: <u>WHITECAP COMMUNITIES INC</u> SCALE: <u>1:500</u> DRAWN BY: <u>STANTEC CONSULTING LTD</u> DATE: <u>MAY 24, 2013</u> APPROVED BY: <u>C.G., P. ENG</u> DATE: <u>-</u> RECEIVED BY: _____ DATE: _____
AS-BUILT SEWER INVERT ELEVATIONS: SANITARY AT 5.0m INSIDE LOT = <u>963.92</u> STORM AT 5.0m INSIDE LOT = <u>963.92</u>	I CERTIFY THAT THE FINAL LANDSCAPE GRADE WILL BE (FRONT) _____ (REAR) _____ SIGNATURE OF OWNER OR REPRESENTATIVE _____
DESIGN LANDSCAPE ELEVATIONS ELEV. AT FRONT OF HOUSE = <u>967.62</u> ELEV. AT REAR OF HOUSE = <u>965.26</u>	


BUILDING GRADE CERTIFICATE

Town of Sylvan Lake
 Issued by: No.

1. WHEN EXCAVATING IN A RIGHT OF WAY (EASEMENT), CHECK FOR UTILITIES.
2. STANDING AT THE WATER SHUTOFF AND FACING THE BUILDING, THE SANITARY SERVICE (PAINTED RED) IS ON THE LEFT SIDE OF THE WATER SERVICE; STORM SERVICE (PAINTED GREEN) IS ON THE RIGHT SIDE OF THE WATER SERVICE.
3. ALL DIMENSIONS ARE IN METRES AND DECIMALS THERE OF. THE ELEVATIONS ARE IN METRES ABOVE GEODETIC MEAN SEA LEVEL.
4. ELEVATIONS NOTED ON THE CERTIFICATE ARE WITHIN 100mm OF ACTUAL.
5. THE BUILDER MUST CONSTRUCT WITHIN 100mm OF THE DESIGN LANDSCAPE ELEVATION & ILLUSTRATED DRAINAGE PATTERNS UNLESS OTHERWISE APPROVED BY THE DEVELOPMENT OFFICER.
6. IF THE INFORMATION ON THIS CERTIFICATE HAS BEEN PREPARED BY A PRIVATE DEVELOPER OR THEIR AGENT, THE TOWN OF SYLVAN LAKE ACCEPTS NO RESPONSIBILITY FOR ITS ACCURACY.

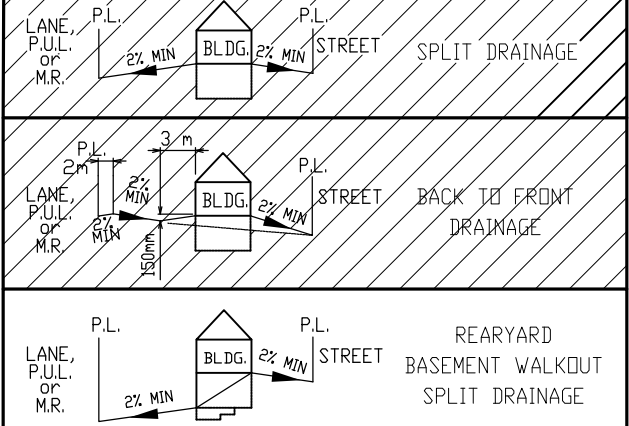

VANVELLER WAY

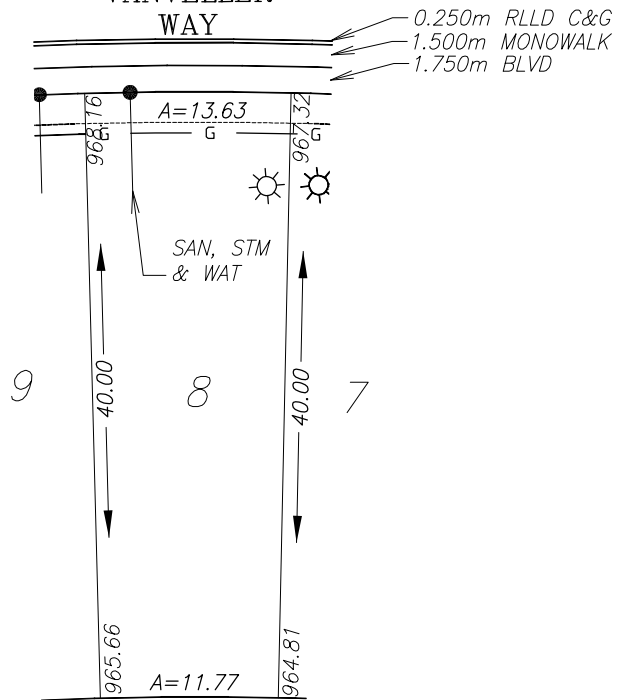

LEGEND

- SAN, WATER & STORM
- ⊙ FIRE HYDRANT
- - - GAS
- ☀ POWER, TELEPHONE & CABLE SERVICE
- STREET LIGHT
- ⊠ COMMUNITY MAILBOX
- TRANSFORMER
- EL&P TRANSFORMER
- SHAW PEDESTAL
- ▲ TELEPHONE PEDESTAL
- URD BOX

WATER, SANITARY AND STORM SERVICE LOCATION IS 3.0m FROM LOTLINE

TOP OF FOOTING:
 MAX. DEPTH BELOW AVERAGE SIDEWALK = 1.67
 LOWEST ELEVATION = 964.07

AS-BUILT SEWER INVERT ELEVATIONS:
 SANITARY AT 5.0m INSIDE LOT = 965.22
 STORM AT 5.0m INSIDE LOT = 965.22

CIVIC ADDRESS: 15 VANVELLER WAY
 LOT: 8 BLOCK: 3 PLAN No.: 132 5350
 DEVELOPER: WHITECAP COMMUNITIES INC SCALE: 1:500
 DRAWN BY: STANTEC CONSULTING LTD DATE: MAY 24, 2013
 APPROVED BY: C.G., P. ENG DATE: -
 RECEIVED BY: DATE:




DESIGN LANDSCAPE ELEVATIONS
 ELEV. AT FRONT OF HOUSE = 968.46
 ELEV. AT REAR OF HOUSE = 966.11

I CERTIFY THAT THE FINAL LANDSCAPE GRADE WILL BE (FRONT) _____
 (REAR) _____
 SIGNATURE OF OWNER OR REPRESENTATIVE _____

BUILDING GRADE CERTIFICATE

Town of Sylvan Lake
 Issued by: No.

1. WHEN EXCAVATING IN A RIGHT OF WAY (EASEMENT), CHECK FOR UTILITIES.
2. STANDING AT THE WATER SHUTOFF AND FACING THE BUILDING, THE SANITARY SERVICE (PAINTED RED) IS ON THE LEFT SIDE OF THE WATER SERVICE; STORM SERVICE (PAINTED GREEN) IS ON THE RIGHT SIDE OF THE WATER SERVICE.
3. ALL DIMENSIONS ARE IN METRES AND DECIMALS THERE OF. THE ELEVATIONS ARE IN METRES ABOVE GEODETIC MEAN SEA LEVEL.
4. ELEVATIONS NOTED ON THE CERTIFICATE ARE WITHIN 100mm OF ACTUAL.
5. THE BUILDER MUST CONSTRUCT WITHIN 100mm OF THE DESIGN LANDSCAPE ELEVATION & ILLUSTRATED DRAINAGE PATTERNS UNLESS OTHERWISE APPROVED BY THE DEVELOPMENT OFFICER.
6. IF THE INFORMATION ON THIS CERTIFICATE HAS BEEN PREPARED BY A PRIVATE DEVELOPER OR THEIR AGENT, THE TOWN OF SYLVAN LAKE ACCEPTS NO RESPONSIBILITY FOR ITS ACCURACY.

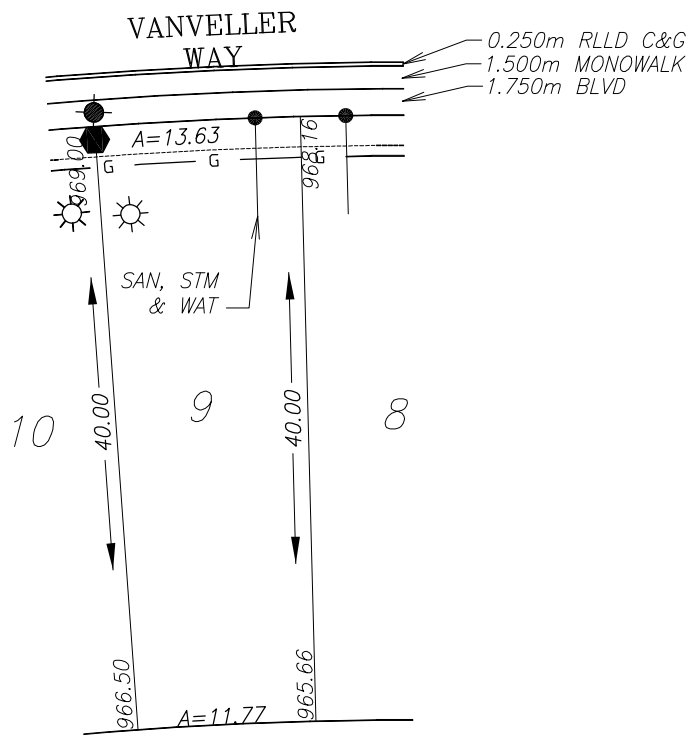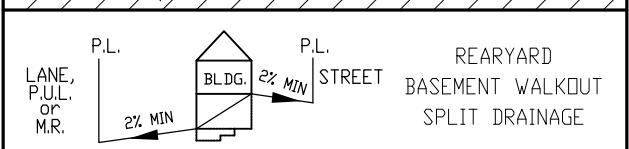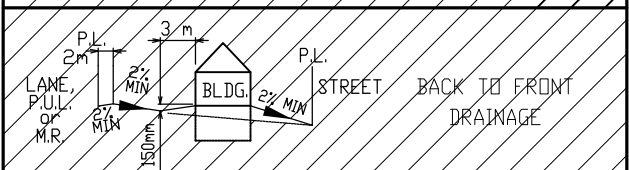

LEGEND

- SAN, WATER & STORM
- ⊙ FIRE HYDRANT
- - - GAS
- ☀ POWER, TELEPHONE & CABLE SERVICE
- STREET LIGHT
- ⊠ COMMUNITY MAILBOX
- TRANSFORMER
- EL&P TRANSFORMER
- SHAW PEDESTAL
- ▲ TELEPHONE PEDESTAL
- URD BOX

WATER, SANITARY AND STORM SERVICE LOCATION IS 3.0m FROM LOTLINE




TOP OF FOOTING: MAX. DEPTH BELOW AVERAGE SIDEWALK = <u>2.14</u> LOWEST ELEVATION = <u>966.44</u>	CIVIC ADDRESS: <u>17 VANVELLER WAY</u> LOT: <u>9</u> BLOCK: <u>3</u> PLAN No.: <u>132 5350</u> DEVELOPER: <u>WHITECAP COMMUNITIES INC</u> SCALE: <u>1:500</u> DRAWN BY: <u>STANTEC CONSULTING LTD</u> DATE: <u>MAY 24, 2013</u> APPROVED BY: <u>C.G., P. ENG</u> DATE: <u>-</u> RECEIVED BY: _____ DATE: _____
AS-BUILT SEWER INVERT ELEVATIONS: SANITARY AT 5.0m INSIDE LOT = <u>965.59</u> STORM AT 5.0m INSIDE LOT = <u>965.59</u>	

DESIGN LANDSCAPE ELEVATIONS ELEV. AT FRONT OF HOUSE = <u>969.30</u> ELEV. AT REAR OF HOUSE = <u>966.95</u>	I CERTIFY THAT THE FINAL LANDSCAPE GRADE WILL BE (FRONT) _____ (REAR) _____ SIGNATURE OF OWNER OR REPRESENTATIVE _____
--	--

BUILDING GRADE CERTIFICATE

Town of Sylvan Lake
 Issued by: _____ No. _____

1. WHEN EXCAVATING IN A RIGHT OF WAY (EASEMENT), CHECK FOR UTILITIES.
2. STANDING AT THE WATER SHUTOFF AND FACING THE BUILDING, THE SANITARY SERVICE (PAINTED RED) IS ON THE LEFT SIDE OF THE WATER SERVICE; STORM SERVICE (PAINTED GREEN) IS ON THE RIGHT SIDE OF THE WATER SERVICE.
3. ALL DIMENSIONS ARE IN METRES AND DECIMALS THERE OF. THE ELEVATIONS ARE IN METRES ABOVE GEODETIC MEAN SEA LEVEL.
4. ELEVATIONS NOTED ON THE CERTIFICATE ARE WITHIN 100mm OF ACTUAL.
5. THE BUILDER MUST CONSTRUCT WITHIN 100mm OF THE DESIGN LANDSCAPE ELEVATION & ILLUSTRATED DRAINAGE PATTERNS UNLESS OTHERWISE APPROVED BY THE DEVELOPMENT OFFICER.
6. IF THE INFORMATION ON THIS CERTIFICATE HAS BEEN PREPARED BY A PRIVATE DEVELOPER OR THEIR AGENT, THE TOWN OF SYLVAN LAKE ACCEPTS NO RESPONSIBILITY FOR ITS ACCURACY.

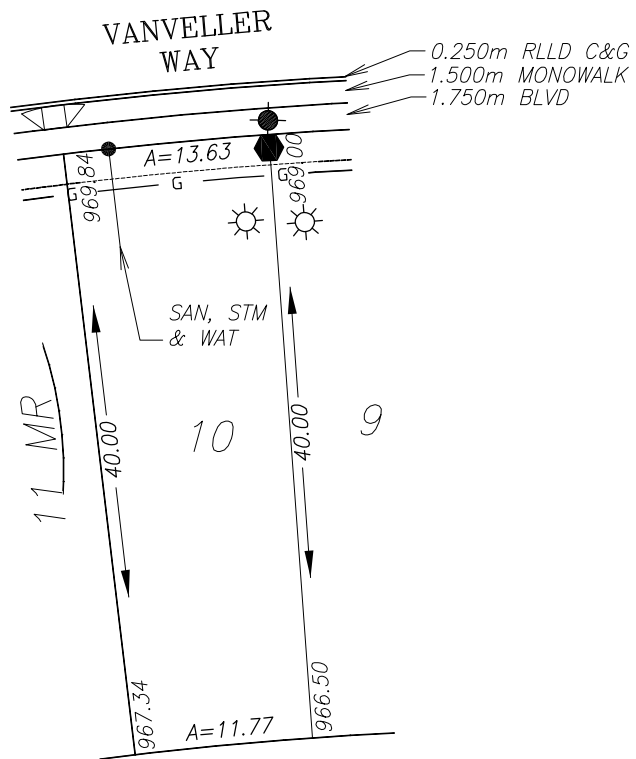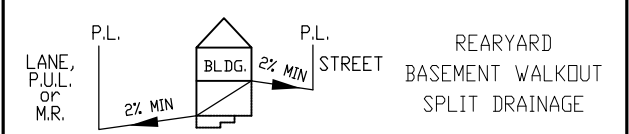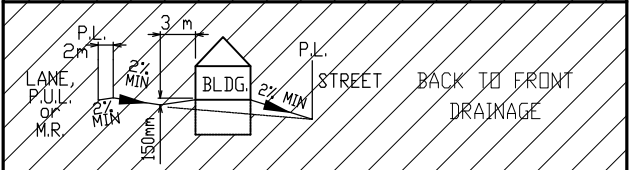

LEGEND

- SAN, WATER & STORM
- ⊙ FIRE HYDRANT
- - - GAS
- ☀ POWER, TELEPHONE & CABLE SERVICE
- STREET LIGHT
- ⊠ COMMUNITY MAILBOX
- TRANSFORMER
- EL&P TRANSFORMER
- SHAW PEDESTAL
- ▲ TELEPHONE PEDESTAL
- URD BOX

WATER, SANITARY AND STORM SERVICE LOCATION IS 3.0m FROM LOTLINE

TOP OF FOOTING:
 MAX. DEPTH BELOW AVERAGE SIDEWALK = 1.68
 LOWEST ELEVATION = 967.74

AS-BUILT SEWER INVERT ELEVATIONS:
 SANITARY AT 5.0m INSIDE LOT = 966.89
 STORM AT 5.0m INSIDE LOT = 966.89

CIVIC ADDRESS: 19 VANVELLER WAY
 LOT: 10 BLOCK: 3 PLAN No.: 132 5350
 DEVELOPER: WHITECAP COMMUNITIES INC SCALE: 1:500
 DRAWN BY: STANTEC CONSULTING LTD DATE: MAY 24, 2013
 APPROVED BY: C.G., P. ENG DATE: -
 RECEIVED BY: _____ DATE: _____



DESIGN LANDSCAPE ELEVATIONS
 ELEV. AT FRONT OF HOUSE = 970.14
 ELEV. AT REAR OF HOUSE = 967.79

I CERTIFY THAT THE FINAL LANDSCAPE GRADE WILL BE (FRONT) _____
 (REAR) _____
 SIGNATURE OF OWNER OR REPRESENTATIVE _____

BUILDING GRADE CERTIFICATE


Town of Sylvan Lake
 Issued by: No.

1. WHEN EXCAVATING IN A RIGHT OF WAY (EASEMENT), CHECK FOR UTILITIES.
2. STANDING AT THE WATER SHUTOFF AND FACING THE BUILDING, THE SANITARY SERVICE (PAINTED RED) IS ON THE LEFT SIDE OF THE WATER SERVICE; STORM SERVICE (PAINTED GREEN) IS ON THE RIGHT SIDE OF THE WATER SERVICE.
3. ALL DIMENSIONS ARE IN METRES AND DECIMALS THERE OF. THE ELEVATIONS ARE IN METRES ABOVE GEODETIC MEAN SEA LEVEL.
4. ELEVATIONS NOTED ON THE CERTIFICATE ARE WITHIN 100mm OF ACTUAL.
5. THE BUILDER MUST CONSTRUCT WITHIN 100mm OF THE DESIGN LANDSCAPE ELEVATION & ILLUSTRATED DRAINAGE PATTERNS UNLESS OTHERWISE APPROVED BY THE DEVELOPMENT OFFICER.
6. IF THE INFORMATION ON THIS CERTIFICATE HAS BEEN PREPARED BY A PRIVATE DEVELOPER OR THEIR AGENT, THE TOWN OF SYLVAN LAKE ACCEPTS NO RESPONSIBILITY FOR ITS ACCURACY.

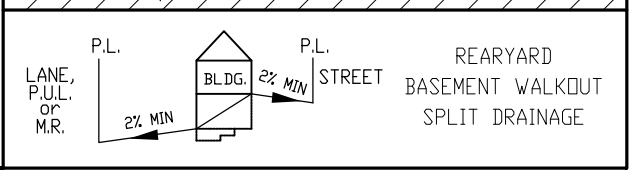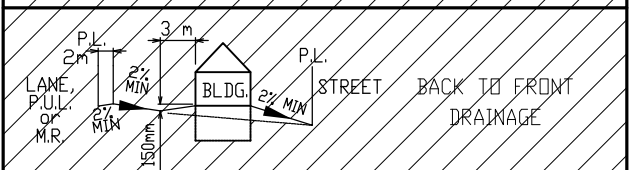

LEGEND

- SAN, WATER & STORM
- ⊙ FIRE HYDRANT
- - - GAS
- ☀ POWER, TELEPHONE & CABLE SERVICE
- STREET LIGHT
- ⊠ COMMUNITY MAILBOX
- TRANSFORMER
- EL&P TRANSFORMER
- SHAW PEDESTAL
- ▲ TELEPHONE PEDESTAL
- URD BOX

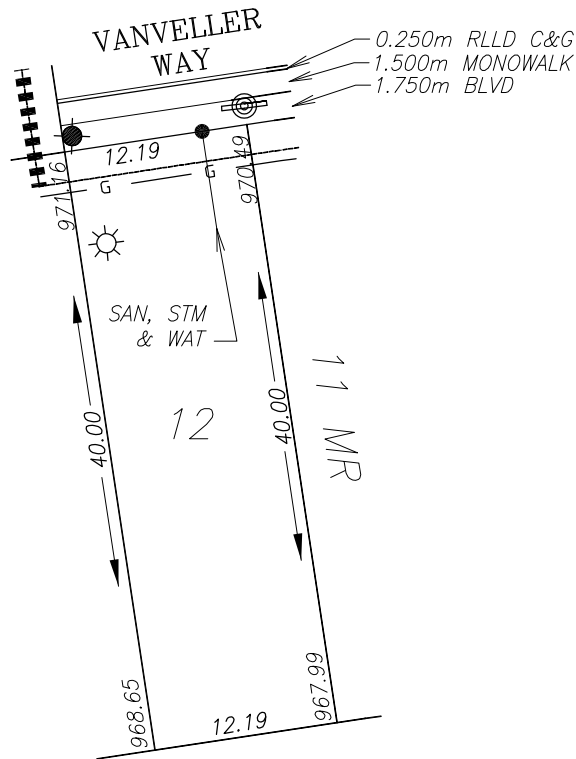

WATER, SANITARY AND STORM SERVICE LOCATION IS 3.0m FROM LOTLINE

TOP OF FOOTING:
 MAX. DEPTH BELOW AVERAGE SIDEWALK = 2.08
 LOWEST ELEVATION = 968.75

AS-BUILT SEWER INVERT ELEVATIONS:
 SANITARY AT 5.0m INSIDE LOT = 967.89
 STORM AT 5.0m INSIDE LOT = 967.89

CIVIC ADDRESS: 23 VANVELLER WAY
 LOT: 12 BLOCK: 3 PLAN No.: 132 5350
 DEVELOPER: WHITECAP COMMUNITIES INC SCALE: 1:500
 DRAWN BY: STANTEC CONSULTING LTD DATE: MAY 24, 2013
 APPROVED BY: C.G., P. ENG DATE: -
 RECEIVED BY: DATE:

DESIGN LANDSCAPE ELEVATIONS
 ELEV. AT FRONT OF HOUSE = 971.46
 ELEV. AT REAR OF HOUSE = 968.95

I CERTIFY THAT THE FINAL LANDSCAPE GRADE WILL BE (FRONT) _____
 (REAR) _____
 SIGNATURE OF OWNER OR REPRESENTATIVE _____