
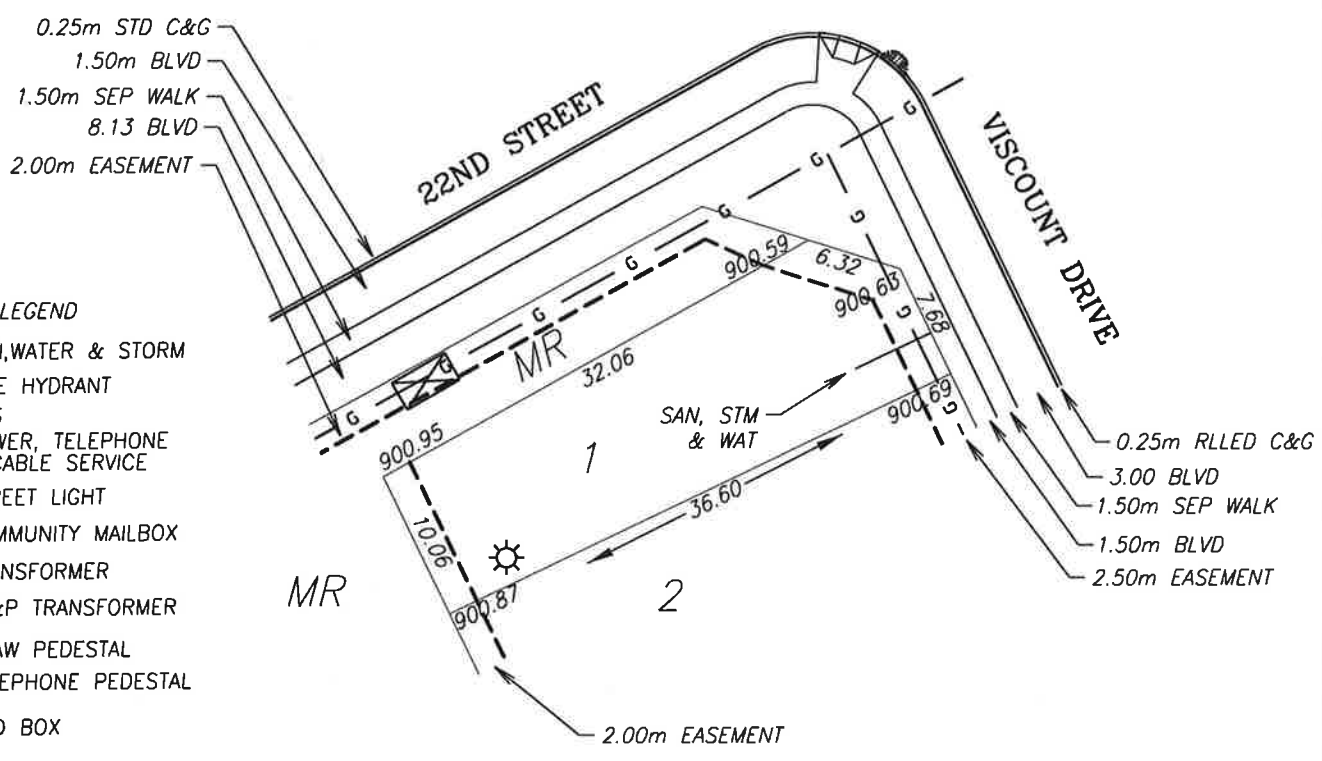


BUILDING GRADE CERTIFICATE

City of Red Deer
 Issued by: No.

1. WHEN EXCAVATING IN A RIGHT OF WAY (EASEMENT), CHECK FOR UTILITIES.
2. STANDING AT THE WATER SHUTOFF AND FACING THE BUILDING, THE SANITARY SERVICE (PAINTED RED) IS ON THE LEFT SIDE OF THE WATER SERVICE. STORM SERVICE (PAINTED GREEN) IS ON THE RIGHT SIDE OF THE WATER SERVICE.
3. ALL DIMENSIONS ARE IN METRES AND DECIMALS THERE OF. THE ELEVATIONS ARE IN METRES ABOVE GEODETIC MEAN SEA LEVEL.
4. ELEVATIONS NOTED ON THE CERTIFICATE ARE WITHIN 100mm OF ACTUAL.
5. THE BUILDER MUST CONSTRUCT WITHIN 100mm OF THE DESIGN LANDSCAPE ELEVATION & ILLUSTRATED DRAINAGE PATTERNS UNLESS OTHERWISE APPROVED BY THE DEVELOPMENT OFFICER.
6. IF THE INFORMATION ON THIS CERTIFICATE HAS BEEN PREPARED BY A PRIVATE DEVELOPER OR THEIR AGENT, THE CITY OF RED DEER ACCEPTS NO RESPONSIBILITY FOR ITS ACCURACY.

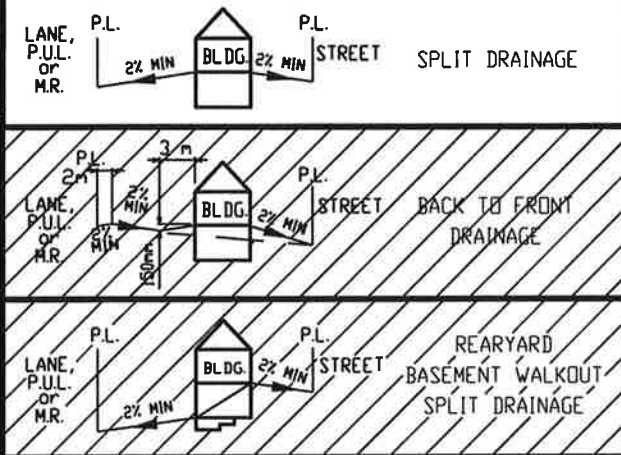



POWER SERVICE LOCATION IS 1.0m FROM SIDEYARD LOTLINE
 SANITARY AND WATER SERVICE LOCATION IS 3.0m FROM SIDEYARD LOTLINE

TOP OF FOOTING: MAX. DEPTH BELOW AVERAGE SIDEWALK = 2.12 LOWEST ELEVATION = 898.52	CIVIC ADDRESS: 358 VISCOUNT DRIVE LOT: 1 BLOCK: 1 PLAN No.: 132 4102 DEVELOPER: MELCOR DEVELOPMENTS SCALE: 1:500 DRAWN BY: STANTEC CONSULTING LTD DATE: Sep 26, 2013 APPROVED BY: KERRY SAUNDERS DATE: Sep 27, 2013 RECEIVED BY: DATE:
AS-BUILT SEWER INVERT ELEVATIONS: SANITARY AT 5.0m INSIDE LOT = 897.67 STORM AT 5.0m INSIDE LOT = 897.67	
DESIGN LANDSCAPE ELEVATIONS ELEV. AT FRONT OF HOUSE = 900.99 ELEV. AT REAR OF HOUSE = 901.25	I CERTIFY THAT THE FINAL LANDSCAPE GRADE WILL BE (FRONT) _____ (REAR) _____ SIGNATURE OF OWNER OR REPRESENTATIVE _____

BUILDING GRADE CERTIFICATE

City of Red Deer
 Issued by: No.

1. WHEN EXCAVATING IN A RIGHT OF WAY (EASEMENT), CHECK FOR UTILITIES.
2. STANDING AT THE WATER SHUTOFF AND FACING THE BUILDING, THE SANITARY SERVICE (PAINTED RED) IS ON THE LEFT SIDE OF THE WATER SERVICE; STORM SERVICE (PAINTED GREEN) IS ON THE RIGHT SIDE OF THE WATER SERVICE.
3. ALL DIMENSIONS ARE IN METRES AND DECIMALS THERE OF. THE ELEVATIONS ARE IN METRES ABOVE GEODETIC MEAN SEA LEVEL.
4. ELEVATIONS NOTED ON THE CERTIFICATE ARE WITHIN 100mm OF ACTUAL.
5. THE BUILDER MUST CONSTRUCT WITHIN 100mm OF THE DESIGN LANDSCAPE ELEVATION & ILLUSTRATED DRAINAGE PATTERNS UNLESS OTHERWISE APPROVED BY THE DEVELOPMENT OFFICER.
6. IF THE INFORMATION ON THIS CERTIFICATE HAS BEEN PREPARED BY A PRIVATE DEVELOPER OR THEIR AGENT, THE CITY OF RED DEER ACCEPTS NO RESPONSIBILITY FOR ITS ACCURACY.

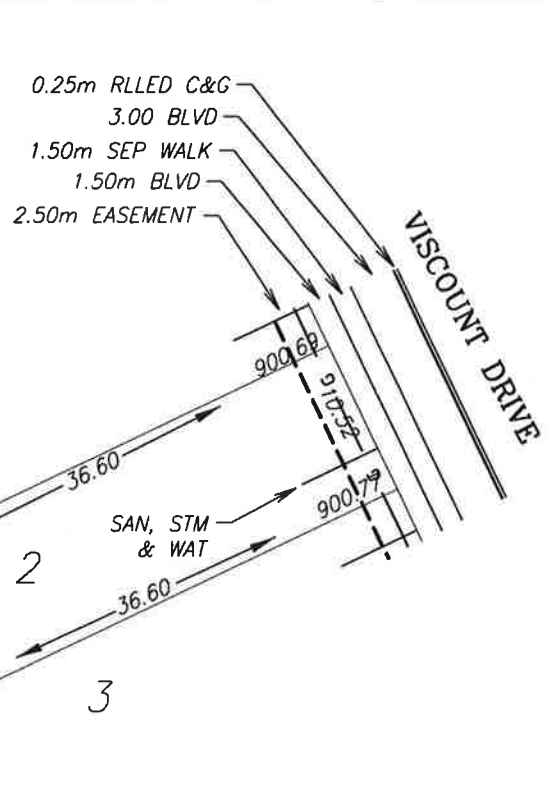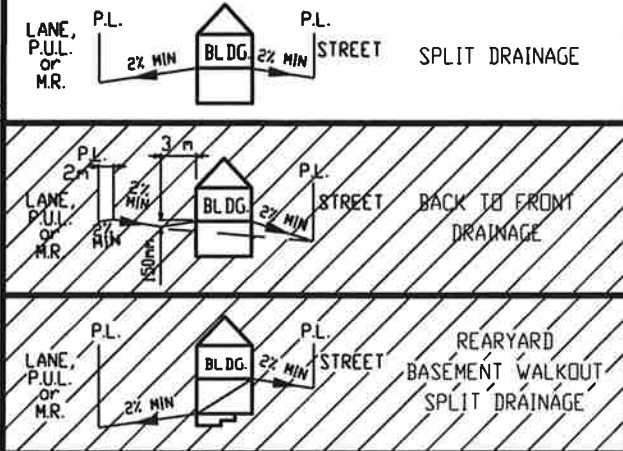

- LEGEND**
- SAN, WATER & STORM
 - ⊙ FIRE HYDRANT
 - - - GAS
 - ⊙ POWER, TELEPHONE & CABLE SERVICE
 - ⊙ STREET LIGHT
 - ⊠ COMMUNITY MAILBOX
 - TRANSFORMER
 - EL&P TRANSFORMER
 - SHAW PEDESTAL
 - ▲ TELEPHONE PEDESTAL
 - URD BOX

POWER SERVICE LOCATION IS 1.0m FROM SIDEYARD LOTLINE
 SANITARY AND WATER SERVICE LOCATION IS 3.0m FROM SIDEYARD LOTLINE

TOP OF FOOTING:
 MAX. DEPTH BELOW AVERAGE SIDEWALK = 2.12
 LOWEST ELEVATION = 898.61

AS-BUILT SEWER INVERT ELEVATIONS:
 SANITARY AT 5.0m INSIDE LOT = 897.76
 STORM AT 5.0m INSIDE LOT = 897.76

CIVIC ADDRESS: 354 VISCOUNT DRIVE
 LOT: 2 BLOCK: 1 PLAN No.: 132 4102
 DEVELOPER: MELCOR DEVELOPMENTS SCALE: 1:500
 DRAWN BY: STANTEC CONSULTING LTD DATE: Sep 26, 2013
 APPROVED BY: KERRY SAUNDERS DATE: Sep 27, 2013
 RECEIVED BY: DATE:



DESIGN LANDSCAPE ELEVATIONS
 ELEV. AT FRONT OF HOUSE = 901.07
 ELEV. AT REAR OF HOUSE = 901.22

I CERTIFY THAT THE FINAL LANDSCAPE GRADE WILL BE (FRONT) _____ (REAR) _____
 SIGNATURE OF OWNER OR REPRESENTATIVE _____

BUILDING GRADE CERTIFICATE

City of Red Deer
 Issued by: _____ No. _____

1. WHEN EXCAVATING IN A RIGHT OF WAY (EASEMENT), CHECK FOR UTILITIES.
2. STANDING AT THE WATER SHUTOFF AND FACING THE BUILDING, THE SANITARY SERVICE (PAINTED RED) IS ON THE LEFT SIDE OF THE WATER SERVICE: STORM SERVICE (PAINTED GREEN) IS ON THE RIGHT SIDE OF THE WATER SERVICE.
3. ALL DIMENSIONS ARE IN METRES AND DECIMALS THERE OF. THE ELEVATIONS ARE IN METRES ABOVE GEODETIC MEAN SEA LEVEL.
4. ELEVATIONS NOTED ON THE CERTIFICATE ARE WITHIN 100mm OF ACTUAL.
5. THE BUILDER MUST CONSTRUCT WITHIN 100mm OF THE DESIGN LANDSCAPE ELEVATION & ILLUSTRATED DRAINAGE PATTERNS UNLESS OTHERWISE APPROVED BY THE DEVELOPMENT OFFICER.
6. IF THE INFORMATION ON THIS CERTIFICATE HAS BEEN PREPARED BY A PRIVATE DEVELOPER OR THEIR AGENT, THE CITY OF RED DEER ACCEPTS NO RESPONSIBILITY FOR ITS ACCURACY.

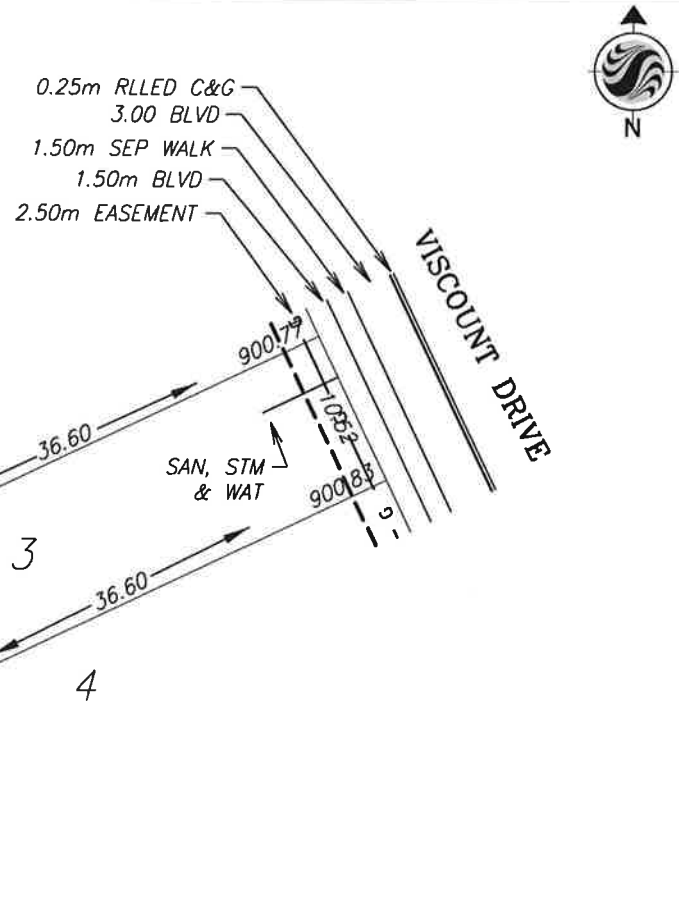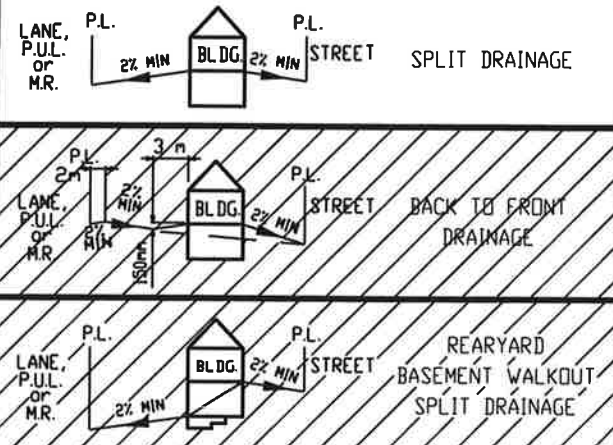

- LEGEND**
- SAN, WATER & STORM
 - ☉ FIRE HYDRANT
 - - - GAS
 - ☼ POWER, TELEPHONE & CABLE SERVICE
 - ☼ STREET LIGHT
 - ☒ COMMUNITY MAILBOX
 - TRANSFORMER
 - EL&P TRANSFORMER
 - SHAW PEDESTAL
 - ▲ TELEPHONE PEDESTAL
 - URD BOX

POWER SERVICE LOCATION IS 1.0m FROM SIDEYARD LOTLINE
 SANITARY AND WATER SERVICE LOCATION IS 3.0m FROM SIDEYARD LOTLINE

TOP OF FOOTING:
 MAX. DEPTH BELOW AVERAGE SIDEWALK = 2.13
 LOWEST ELEVATION = 898.67

AS-BUILT SEWER INVERT ELEVATIONS:
 SANITARY AT 5.0m INSIDE LOT = 897.82
 STORM AT 5.0m INSIDE LOT = 897.82

CIVIC ADDRESS: 350 VISCOUNT DRIVE
 LOT: 3 BLOCK: 1 PLAN No.: 132 4102
 DEVELOPER: MELCOR DEVELOPMENTS SCALE: 1:500
 DRAWN BY: STANTEC CONSULTING LTD DATE: Sep 26, 2013
 APPROVED BY: KERRY SAUNDERS DATE: Sep 27, 2013
 RECEIVED BY: _____ DATE: _____



DESIGN LANDSCAPE ELEVATIONS
 ELEV. AT FRONT OF HOUSE = 901.13
 ELEV. AT REAR OF HOUSE = 901.14

I CERTIFY THAT THE FINAL LANDSCAPE GRADE WILL BE (FRONT) _____
 (REAR) _____
 SIGNATURE OF OWNER OR REPRESENTATIVE _____

BUILDING GRADE CERTIFICATE

City of Red Deer
 Issued by: _____ No. _____

1. WHEN EXCAVATING IN A RIGHT OF WAY (EASEMENT), CHECK FOR UTILITIES.
2. STANDING AT THE WATER SHUTOFF AND FACING THE BUILDING, THE SANITARY SERVICE (PAINTED RED) IS ON THE LEFT SIDE OF THE WATER SERVICE: STORM SERVICE (PAINTED GREEN) IS ON THE RIGHT SIDE OF THE WATER SERVICE.
3. ALL DIMENSIONS ARE IN METRES AND DECIMALS THERE OF. THE ELEVATIONS ARE IN METRES ABOVE GEODETIC MEAN SEA LEVEL.
4. ELEVATIONS NOTED ON THE CERTIFICATE ARE WITHIN 100mm OF ACTUAL.
5. THE BUILDER MUST CONSTRUCT WITHIN 100mm OF THE DESIGN LANDSCAPE ELEVATION & ILLUSTRATED DRAINAGE PATTERNS UNLESS OTHERWISE APPROVED BY THE DEVELOPMENT OFFICER.
6. IF THE INFORMATION ON THIS CERTIFICATE HAS BEEN PREPARED BY A PRIVATE DEVELOPER OR THEIR AGENT, THE CITY OF RED DEER ACCEPTS NO RESPONSIBILITY FOR ITS ACCURACY.

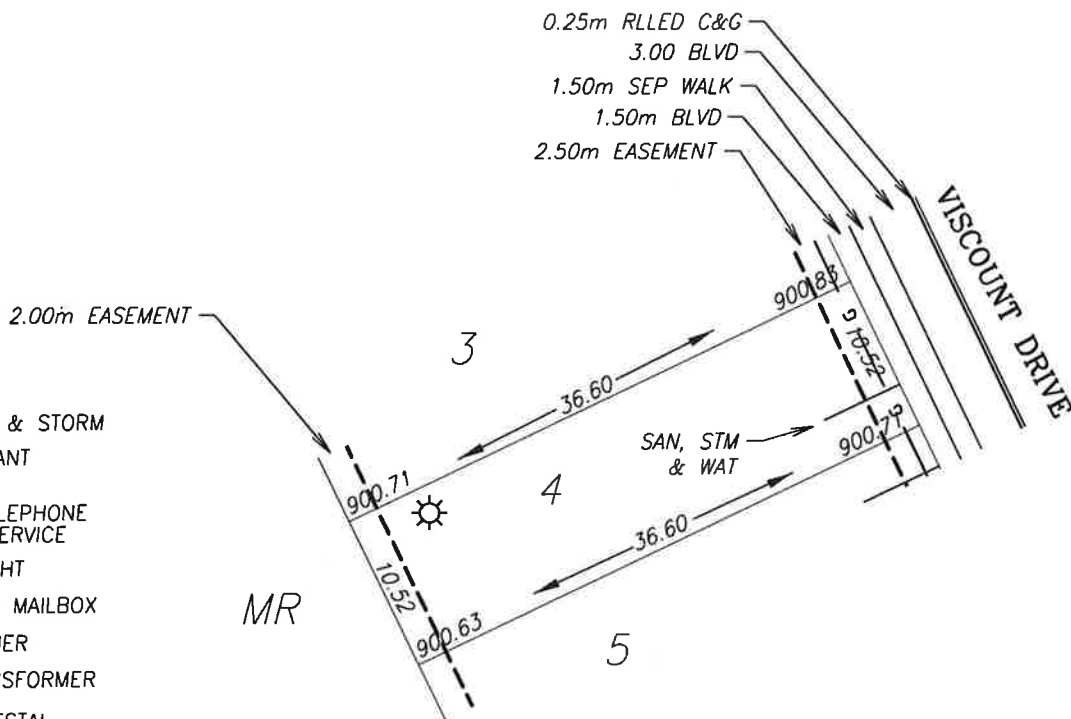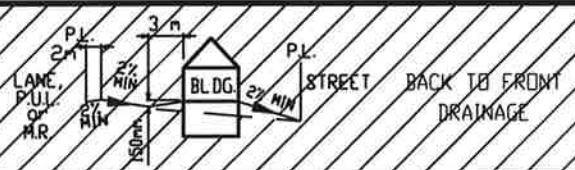

LEGEND

- SAN, WATER & STORM
- ⊙ FIRE HYDRANT
- - - GAS
- ☀ POWER, TELEPHONE & CABLE SERVICE
- ⊙ STREET LIGHT
- ☒ COMMUNITY MAILBOX
- TRANSFORMER
- EL&P TRANSFORMER
- SHAW PEDESTAL
- ▲ TELEPHONE PEDESTAL
- URD BOX

POWER SERVICE LOCATION IS 1.0m FROM SIDEYARD LOTLINE
 SANITARY AND WATER SERVICE LOCATION IS 3.0m FROM SIDEYARD LOTLINE

TOP OF FOOTING:
 MAX. DEPTH BELOW AVERAGE SIDEWALK = 2.19
 LOWEST ELEVATION = 898.58

AS-BUILT SEWER INVERT ELEVATIONS:
 SANITARY AT 5.0m INSIDE LOT = 897.73
 STORM AT 5.0m INSIDE LOT = 897.73

CIVIC ADDRESS: 346 VISCOUNT DRIVE
 LOT: 4 BLOCK: 1 PLAN No.: 132 4102
 DEVELOPER: MELCOR DEVELOPMENTS SCALE: 1:500
 DRAWN BY: STANTEC CONSULTING LTD DATE: Sep 26, 2013
 APPROVED BY: KERRY SAUNDERS DATE: Sep 27, 2013
 RECEIVED BY: _____ DATE: _____



DESIGN LANDSCAPE ELEVATIONS
 ELEV. AT FRONT OF HOUSE = 901.13
 ELEV. AT REAR OF HOUSE = 901.06

I CERTIFY THAT THE FINAL LANDSCAPE GRADE WILL BE (FRONT) _____ (REAR) _____
 SIGNATURE OF OWNER OR REPRESENTATIVE _____

BUILDING GRADE CERTIFICATE

City of Red Deer
 Issued by: No.

1. WHEN EXCAVATING IN A RIGHT OF WAY (EASEMENT), CHECK FOR UTILITIES.
2. STANDING AT THE WATER SHUTOFF AND FACING THE BUILDING, THE SANITARY SERVICE (PAINTED RED) IS ON THE LEFT SIDE OF THE WATER SERVICE; STORM SERVICE (PAINTED GREEN) IS ON THE RIGHT SIDE OF THE WATER SERVICE.
3. ALL DIMENSIONS ARE IN METRES AND DECIMALS THERE OF. THE ELEVATIONS ARE IN METRES ABOVE GEODETIC MEAN SEA LEVEL.
4. ELEVATIONS NOTED ON THE CERTIFICATE ARE WITHIN 100mm OF ACTUAL.
5. THE BUILDER MUST CONSTRUCT WITHIN 100mm OF THE DESIGN LANDSCAPE ELEVATION & ILLUSTRATED DRAINAGE PATTERNS UNLESS OTHERWISE APPROVED BY THE DEVELOPMENT OFFICER.
6. IF THE INFORMATION ON THIS CERTIFICATE HAS BEEN PREPARED BY A PRIVATE DEVELOPER OR THEIR AGENT, THE CITY OF RED DEER ACCEPTS NO RESPONSIBILITY FOR ITS ACCURACY.

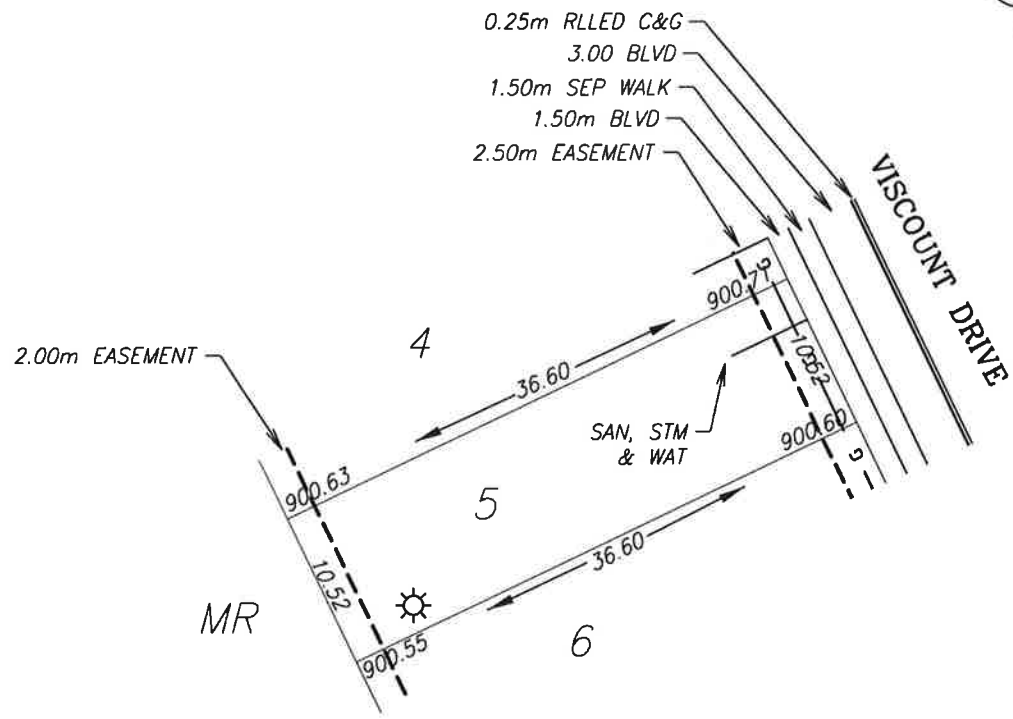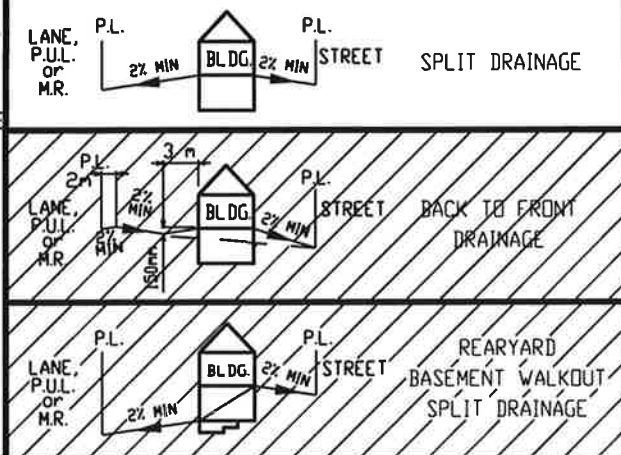

- LEGEND**
- SAN, WATER & STORM
 - ⊙ FIRE HYDRANT
 - - - GAS
 - ☀ POWER, TELEPHONE & CABLE SERVICE
 - ⊙ STREET LIGHT
 - ☒ COMMUNITY MAILBOX
 - TRANSFORMER
 - EL&P TRANSFORMER
 - SHAW PEDESTAL
 - ▲ TELEPHONE PEDESTAL
 - URD BOX




POWER SERVICE LOCATION IS 1.0m FROM SIDEYARD LOTLINE
 SANITARY AND WATER SERVICE LOCATION IS 3.0m FROM SIDEYARD LOTLINE

<p>TOP OF FOOTING: MAX. DEPTH BELOW AVERAGE SIDEWALK = <u>2.09</u> LOWEST ELEVATION = <u>898.56</u></p>	<p>CIVIC ADDRESS: <u>342 VISCOUNT DRIVE</u> LOT: <u>5</u> BLOCK: <u>1</u> PLAN No.: <u>132 4102</u> DEVELOPER: <u>MELCOR DEVELOPMENTS</u> SCALE: <u>1:500</u> DRAWN BY: <u>STANTEC CONSULTING LTD</u> DATE: <u>Sep 26, 2013</u> APPROVED BY: <u>KERRY SAUNDERS</u> DATE: <u>Sep 27, 2013</u> RECEIVED BY: _____ DATE: _____</p>
<p>AS-BUILT SEWER INVERT ELEVATIONS: SANITARY AT 5.0m INSIDE LOT = <u>897.71</u> STORM AT 5.0m INSIDE LOT = <u>897.71</u></p>	<p>I CERTIFY THAT THE FINAL LANDSCAPE GRADE WILL BE (FRONT) _____ (REAR) _____ SIGNATURE OF OWNER OR REPRESENTATIVE _____</p>
<p>DESIGN LANDSCAPE ELEVATIONS ELEV. AT FRONT OF HOUSE = <u>901.01</u> ELEV. AT REAR OF HOUSE = <u>900.98</u></p>	

BUILDING GRADE CERTIFICATE

City of Red Deer
 Issued by: _____ No. _____

1. WHEN EXCAVATING IN A RIGHT OF WAY (EASEMENT), CHECK FOR UTILITIES.
2. STANDING AT THE WATER SHUTOFF AND FACING THE BUILDING, THE SANITARY SERVICE (PAINTED RED) IS ON THE LEFT SIDE OF THE WATER SERVICE: STORM SERVICE (PAINTED GREEN) IS ON THE RIGHT SIDE OF THE WATER SERVICE.
3. ALL DIMENSIONS ARE IN METRES AND DECIMALS THERE OF. THE ELEVATIONS ARE IN METRES ABOVE GEODETIC MEAN SEA LEVEL.
4. ELEVATIONS NOTED ON THE CERTIFICATE ARE WITHIN 100mm OF ACTUAL.
5. THE BUILDER MUST CONSTRUCT WITHIN 100mm OF THE DESIGN LANDSCAPE ELEVATION & ILLUSTRATED DRAINAGE PATTERNS UNLESS OTHERWISE APPROVED BY THE DEVELOPMENT OFFICER.
6. IF THE INFORMATION ON THIS CERTIFICATE HAS BEEN PREPARED BY A PRIVATE DEVELOPER OR THEIR AGENT, THE CITY OF RED DEER ACCEPTS NO RESPONSIBILITY FOR ITS ACCURACY.

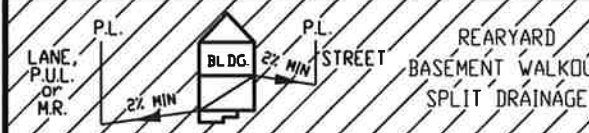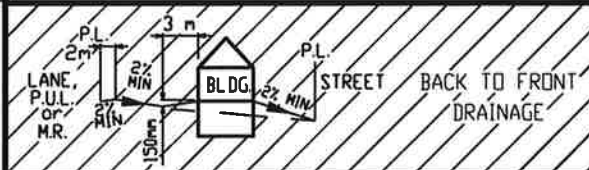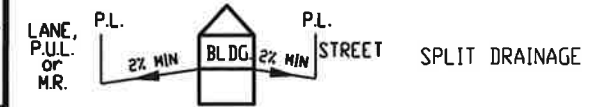

0.25m RILLED C&G
 3.00 BLVD
 1.50m SEP WALK
 1.50m BLVD
 2.50m EASEMENT

VISCOUNT DRIVE

2.00m EASEMENT

MR

- LEGEND**
- SAN, WATER & STORM
 - ☉ FIRE HYDRANT
 - - - GAS
 - ☀ POWER, TELEPHONE & CABLE SERVICE
 - ☹ STREET LIGHT
 - ☒ COMMUNITY MAILBOX
 - TRANSFORMER
 - EL&P TRANSFORMER
 - SHAW PEDESTAL
 - ▲ TELEPHONE PEDESTAL
 - URD BOX

POWER SERVICE LOCATION IS 1.0m FROM SIDEYARD LOTLINE
 SANITARY AND WATER SERVICE LOCATION IS 3.0m FROM SIDEYARD LOTLINE

TOP OF FOOTING:
 MAX. DEPTH BELOW AVERAGE SIDEWALK = 2.21
 LOWEST ELEVATION = 898.33

AS-BUILT SEWER INVERT ELEVATIONS:
 SANITARY AT 5.0m INSIDE LOT = 897.48
 STORM AT 5.0m INSIDE LOT = 897.48

CIVIC ADDRESS: 338 VISCOUNT DRIVE
 LOT: 6 BLOCK: 1 PLAN No.: 132 4102
 DEVELOPER: MELCOR DEVELOPMENTS SCALE: 1:500
 DRAWN BY: STANTEC CONSULTING LTD DATE: Sep 26, 2013
 APPROVED BY: KERRY SAUNDERS DATE: Sep 27, 2013
 RECEIVED BY: _____ DATE: _____



DESIGN LANDSCAPE ELEVATIONS
 ELEV. AT FRONT OF HOUSE = 900.90
 ELEV. AT REAR OF HOUSE = 900.90

I CERTIFY THAT THE FINAL LANDSCAPE GRADE WILL BE (FRONT) _____
 (REAR) _____
 SIGNATURE OF OWNER OR REPRESENTATIVE _____

BUILDING GRADE CERTIFICATE

City of Red Deer
 Issued by: No.

1. WHEN EXCAVATING IN A RIGHT OF WAY (EASEMENT), CHECK FOR UTILITIES.
2. STANDING AT THE WATER SHUTOFF AND FACING THE BUILDING, THE SANITARY SERVICE (PAINTED RED) IS ON THE LEFT SIDE OF THE WATER SERVICE: STORM SERVICE (PAINTED GREEN) IS ON THE RIGHT SIDE OF THE WATER SERVICE.
3. ALL DIMENSIONS ARE IN METRES AND DECIMALS THERE OF. THE ELEVATIONS ARE IN METRES ABOVE GEODETIC MEAN SEA LEVEL.
4. ELEVATIONS NOTED ON THE CERTIFICATE ARE WITHIN 100mm OF ACTUAL.
5. THE BUILDER MUST CONSTRUCT WITHIN 100mm OF THE DESIGN LANDSCAPE ELEVATION & ILLUSTRATED DRAINAGE PATTERNS UNLESS OTHERWISE APPROVED BY THE DEVELOPMENT OFFICER.
6. IF THE INFORMATION ON THIS CERTIFICATE HAS BEEN PREPARED BY A PRIVATE DEVELOPER OR THEIR AGENT, THE CITY OF RED DEER ACCEPTS NO RESPONSIBILITY FOR ITS ACCURACY.

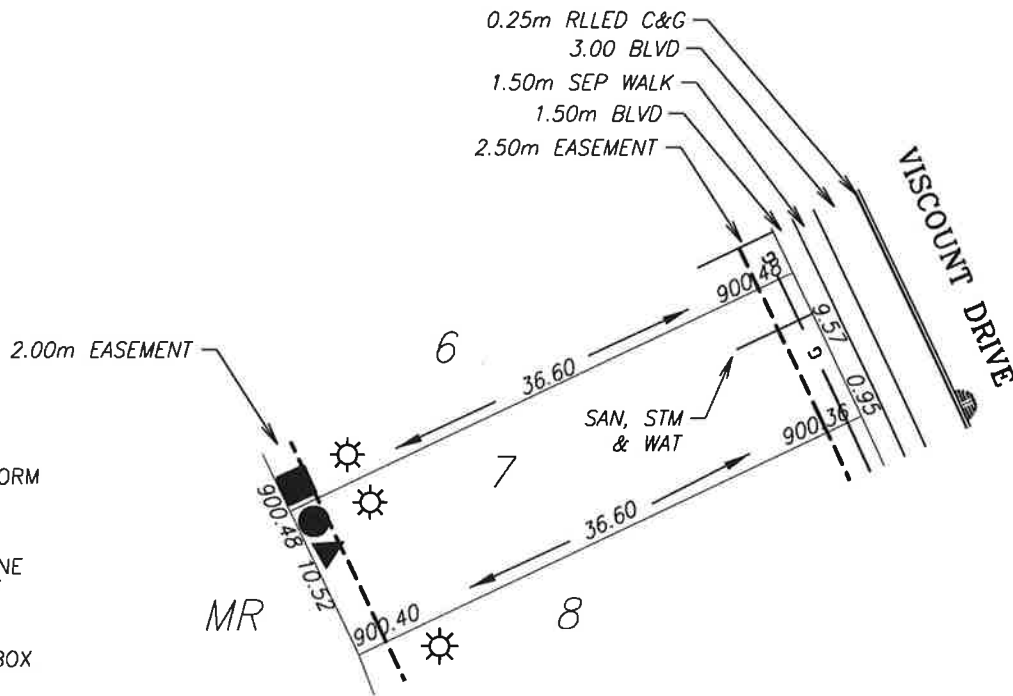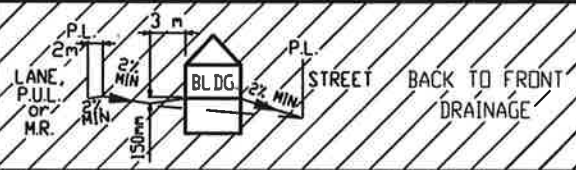

LEGEND

- SAN, WATER & STORM
- ⊙ FIRE HYDRANT
- - - GAS
- ☀ POWER, TELEPHONE & CABLE SERVICE
- ⊙ STREET LIGHT
- ⊠ COMMUNITY MAILBOX
- TRANSFORMER
- EL&P TRANSFORMER
- SHAW PEDESTAL
- ▲ TELEPHONE PEDESTAL
- URD BOX

POWER SERVICE LOCATION IS 1.0m FROM SIDEYARD LOTLINE
 SANITARY AND WATER SERVICE LOCATION IS 3.0m FROM SIDEYARD LOTLINE

TOP OF FOOTING:
 MAX. DEPTH BELOW AVERAGE SIDEWALK = 2.14
 LOWEST ELEVATION = 898.28

AS-BUILT SEWER INVERT ELEVATIONS:
 SANITARY AT 5.0m INSIDE LOT = 897.43
 STORM AT 5.0m INSIDE LOT = 897.43

CIVIC ADDRESS: 334 VISCOUNT DRIVE
 LOT: 7 BLOCK: 1 PLAN No.: 132 4102
 DEVELOPER: MELCOR DEVELOPMENTS SCALE: 1:500
 DRAWN BY: STANTEC CONSULTING LTD DATE: Sep 26, 2013
 APPROVED BY: KERRY SAUNDERS DATE: Sep 27, 2013
 RECEIVED BY: _____ DATE: _____


DESIGN LANDSCAPE ELEVATIONS
 ELEV. AT FRONT OF HOUSE = 900.78
 ELEV. AT REAR OF HOUSE = 900.83

I CERTIFY THAT THE FINAL LANDSCAPE GRADE WILL BE (FRONT) _____ (REAR) _____
 SIGNATURE OF OWNER OR REPRESENTATIVE _____


BUILDING GRADE CERTIFICATE

City of Red Deer
 Issued by: No.

1. WHEN EXCAVATING IN A RIGHT OF WAY (EASEMENT), CHECK FOR UTILITIES.
2. STANDING AT THE WATER SHUTOFF AND FACING THE BUILDING, THE SANITARY SERVICE (PAINTED RED) IS ON THE LEFT SIDE OF THE WATER SERVICE: STORM SERVICE (PAINTED GREEN) IS ON THE RIGHT SIDE OF THE WATER SERVICE.
3. ALL DIMENSIONS ARE IN METRES AND DECIMALS THERE OF. THE ELEVATIONS ARE IN METRES ABOVE GEODETIC MEAN SEA LEVEL.
4. ELEVATIONS NOTED ON THE CERTIFICATE ARE WITHIN 100mm OF ACTUAL.
5. THE BUILDER MUST CONSTRUCT WITHIN 100mm OF THE DESIGN LANDSCAPE ELEVATION & ILLUSTRATED DRAINAGE PATTERNS UNLESS OTHERWISE APPROVED BY THE DEVELOPMENT OFFICER.
6. IF THE INFORMATION ON THIS CERTIFICATE HAS BEEN PREPARED BY A PRIVATE DEVELOPER OR THEIR AGENT, THE CITY OF RED DEER ACCEPTS NO RESPONSIBILITY FOR ITS ACCURACY.

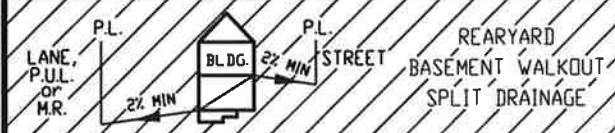

- LEGEND**
- SAN, WATER & STORM
 - ⊙ FIRE HYDRANT
 - - - GAS
 - ⊙ POWER, TELEPHONE & CABLE SERVICE
 - ⊙ STREET LIGHT
 - ⊙ COMMUNITY MAILBOX
 - TRANSFORMER
 - EL&P TRANSFORMER
 - SHAW PEDESTAL
 - ▲ TELEPHONE PEDESTAL
 - URD BOX

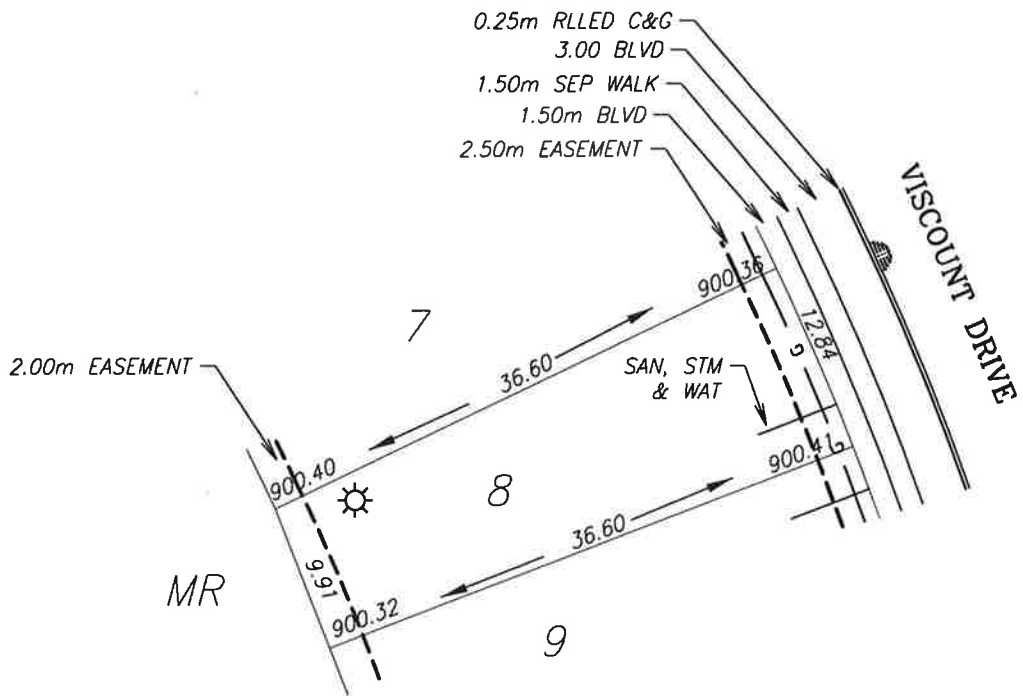

POWER SERVICE LOCATION IS 1.0m FROM SIDEYARD LOTLINE
 SANITARY AND WATER SERVICE LOCATION IS 3.0m FROM SIDEYARD LOTLINE

TOP OF FOOTING:
 MAX. DEPTH BELOW AVERAGE SIDEWALK = 2.12
 LOWEST ELEVATION = 898.26

AS-BUILT SEWER INVERT ELEVATIONS:
 SANITARY AT 5.0m INSIDE LOT = 897.41
 STORM AT 5.0m INSIDE LOT = 897.41

CIVIC ADDRESS: 330 VISCOUNT DRIVE
 LOT: 8 BLOCK: 1 PLAN No.: 132 4102
 DEVELOPER: MELCOR DEVELOPMENTS SCALE: 1:500
 DRAWN BY: STANTEC CONSULTING LTD DATE: Sep 26, 2013
 APPROVED BY: KERRY SAUNDERS DATE: Sep 27, 2013
 RECEIVED BY: DATE:



DESIGN LANDSCAPE ELEVATIONS
 ELEV. AT FRONT OF HOUSE = 900.71
 ELEV. AT REAR OF HOUSE = 900.75

I CERTIFY THAT THE FINAL LANDSCAPE GRADE WILL BE (FRONT) _____
 (REAR) _____
 SIGNATURE OF OWNER OR REPRESENTATIVE _____

BUILDING GRADE CERTIFICATE

City of Red Deer
 Issued by: _____ No. _____

1. WHEN EXCAVATING IN A RIGHT OF WAY (EASEMENT), CHECK FOR UTILITIES.
2. STANDING AT THE WATER SHUTOFF AND FACING THE BUILDING, THE SANITARY SERVICE (PAINTED RED) IS ON THE LEFT SIDE OF THE WATER SERVICE. STORM SERVICE (PAINTED GREEN) IS ON THE RIGHT SIDE OF THE WATER SERVICE.
3. ALL DIMENSIONS ARE IN METRES AND DECIMALS THERE OF. THE ELEVATIONS ARE IN METRES ABOVE GEODETIC MEAN SEA LEVEL.
4. ELEVATIONS NOTED ON THE CERTIFICATE ARE WITHIN 100mm OF ACTUAL.
5. THE BUILDER MUST CONSTRUCT WITHIN 100mm OF THE DESIGN LANDSCAPE ELEVATION & ILLUSTRATED DRAINAGE PATTERNS UNLESS OTHERWISE APPROVED BY THE DEVELOPMENT OFFICER.
6. IF THE INFORMATION ON THIS CERTIFICATE HAS BEEN PREPARED BY A PRIVATE DEVELOPER OR THEIR AGENT, THE CITY OF RED DEER ACCEPTS NO RESPONSIBILITY FOR ITS ACCURACY.

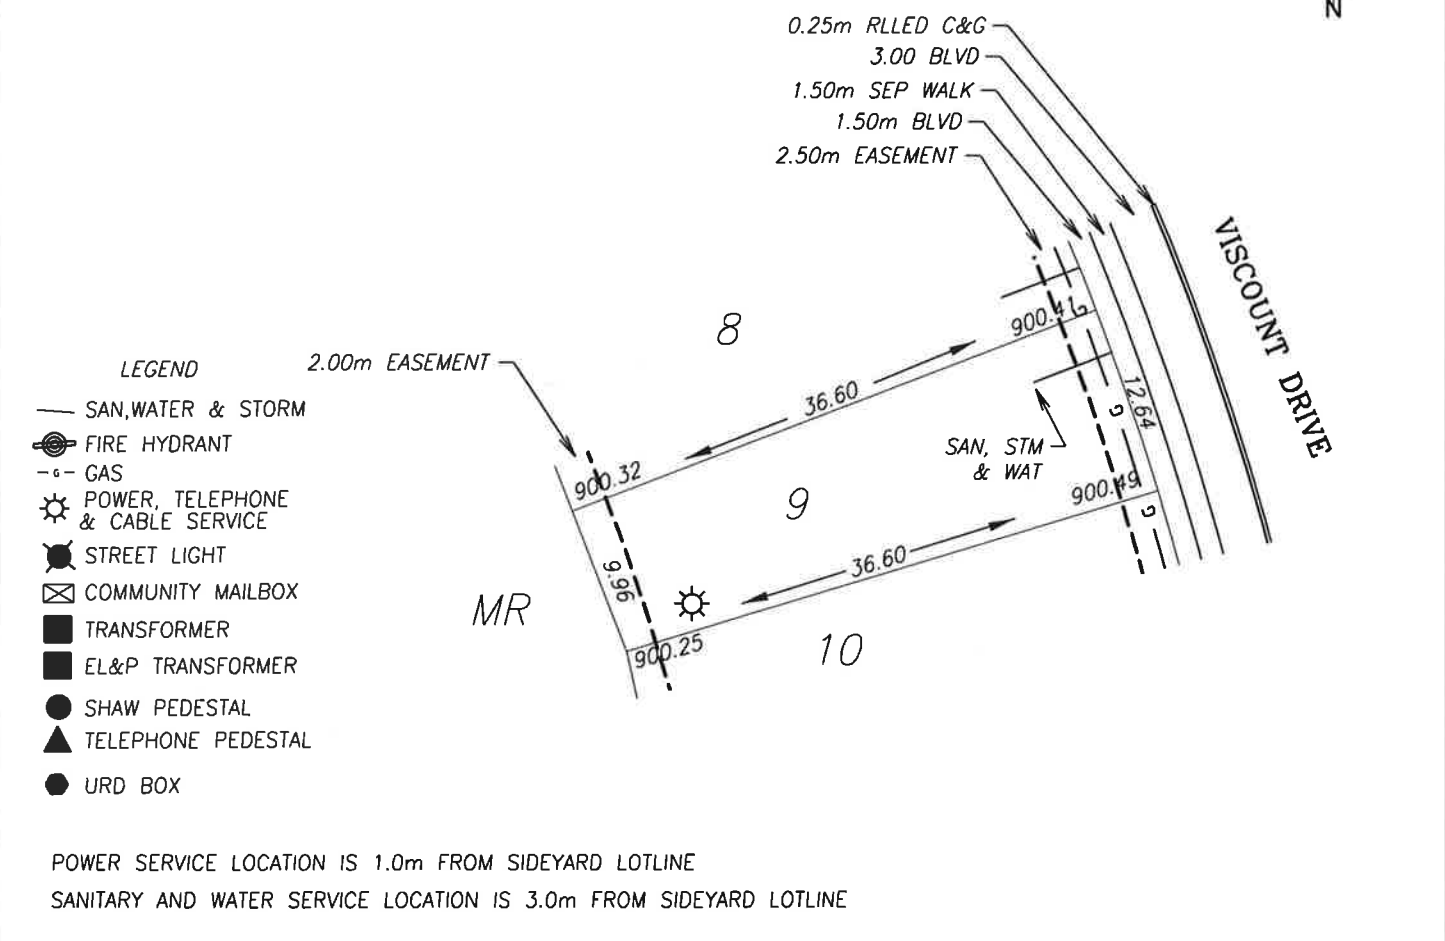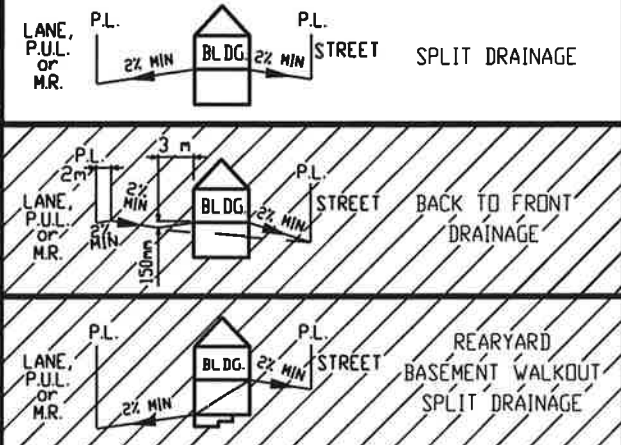

TOP OF FOOTING:
 MAX. DEPTH BELOW AVERAGE SIDEWALK = 2.17
 LOWEST ELEVATION = 898.28

AS-BUILT SEWER INVERT ELEVATIONS:
 SANITARY AT 5.0m INSIDE LOT = 897.43
 STORM AT 5.0m INSIDE LOT = 897.43

CIVIC ADDRESS: 326 VISCOUNT DRIVE
 LOT: 9 BLOCK: 1 PLAN No.: 132 4102
 DEVELOPER: MELCOR DEVELOPMENTS SCALE: 1:500
 DRAWN BY: STANTEC CONSULTING LTD DATE: Sep 26, 2013
 APPROVED BY: KERRY SAUNDERS DATE: Sep 27, 2013
 RECEIVED BY: _____ DATE: _____



DESIGN LANDSCAPE ELEVATIONS
 ELEV. AT FRONT OF HOUSE = 900.79
 ELEV. AT REAR OF HOUSE = 900.67

I CERTIFY THAT THE FINAL LANDSCAPE GRADE WILL BE (FRONT) _____
 (REAR) _____
 SIGNATURE OF OWNER OR REPRESENTATIVE _____

BUILDING GRADE CERTIFICATE

City of Red Deer
 Issued by: _____ No. _____

1. WHEN EXCAVATING IN A RIGHT OF WAY (EASEMENT), CHECK FOR UTILITIES.
2. STANDING AT THE WATER SHUTOFF AND FACING THE BUILDING, THE SANITARY SERVICE (PAINTED RED) IS ON THE LEFT SIDE OF THE WATER SERVICE: STORM SERVICE (PAINTED GREEN) IS ON THE RIGHT SIDE OF THE WATER SERVICE.
3. ALL DIMENSIONS ARE IN METRES AND DECIMALS THERE OF. THE ELEVATIONS ARE IN METRES ABOVE GEODETIC MEAN SEA LEVEL.
4. ELEVATIONS NOTED ON THE CERTIFICATE ARE WITHIN 100mm OF ACTUAL.
5. THE BUILDER MUST CONSTRUCT WITHIN 100mm OF THE DESIGN LANDSCAPE ELEVATION & ILLUSTRATED DRAINAGE PATTERNS UNLESS OTHERWISE APPROVED BY THE DEVELOPMENT OFFICER.
6. IF THE INFORMATION ON THIS CERTIFICATE HAS BEEN PREPARED BY A PRIVATE DEVELOPER OR THEIR AGENT, THE CITY OF RED DEER ACCEPTS NO RESPONSIBILITY FOR ITS ACCURACY.

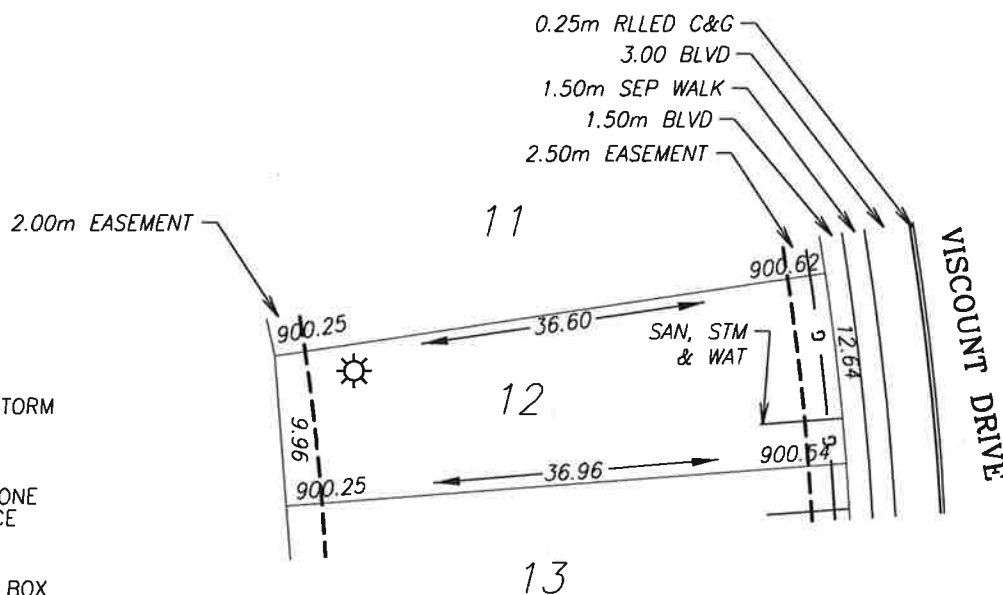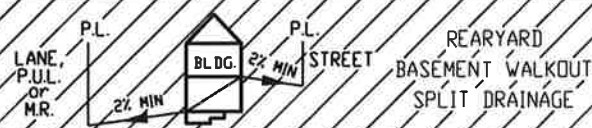

LEGEND

- SAN, WATER & STORM
- ☉ FIRE HYDRANT
- - - GAS
- ☀ POWER, TELEPHONE & CABLE SERVICE
- ☼ STREET LIGHT
- ☒ COMMUNITY MAILBOX
- TRANSFORMER
- EL&P TRANSFORMER
- SHAW PEDESTAL
- ▲ TELEPHONE PEDESTAL
- URD BOX

POWER SERVICE LOCATION IS 1.0m FROM SIDEYARD LOTLINE
 SANITARY AND WATER SERVICE LOCATION IS 3.0m FROM SIDEYARD LOTLINE

TOP OF FOOTING:
 MAX. DEPTH BELOW AVERAGE SIDEWALK = 2.18
 LOWEST ELEVATION = 898.40

AS-BUILT SEWER INVERT ELEVATIONS:
 SANITARY AT 5.0m INSIDE LOT = 897.55
 STORM AT 5.0m INSIDE LOT = 897.55

CIVIC ADDRESS: 314 VISCOUNT DRIVE
 LOT: 12 BLOCK: 1 PLAN No.: 132 4102
 DEVELOPER: MELCOR DEVELOPMENTS SCALE: 1:500
 DRAWN BY: STANTEC CONSULTING LTD DATE: Sep 26, 2013
 APPROVED BY: KERRY SAUNDERS DATE: Sep 27, 2013
 RECEIVED BY: _____ DATE: _____




DESIGN LANDSCAPE ELEVATIONS
 ELEV. AT FRONT OF HOUSE = 900.92
 ELEV. AT REAR OF HOUSE = 900.60

I CERTIFY THAT THE FINAL LANDSCAPE GRADE WILL BE (FRONT) _____
 (REAR) _____
 SIGNATURE OF OWNER OR REPRESENTATIVE _____


BUILDING GRADE CERTIFICATE

City of Red Deer
 Issued by: _____ No. _____

1. WHEN EXCAVATING IN A RIGHT OF WAY (EASEMENT), CHECK FOR UTILITIES.
2. STANDING AT THE WATER SHUTOFF AND FACING THE BUILDING, THE SANITARY SERVICE (PAINTED RED) IS ON THE LEFT SIDE OF THE WATER SERVICE; STORM SERVICE (PAINTED GREEN) IS ON THE RIGHT SIDE OF THE WATER SERVICE.
3. ALL DIMENSIONS ARE IN METRES AND DECIMALS THERE OF. THE ELEVATIONS ARE IN METRES ABOVE GEODETIC MEAN SEA LEVEL.
4. ELEVATIONS NOTED ON THE CERTIFICATE ARE WITHIN 100mm OF ACTUAL.
5. THE BUILDER MUST CONSTRUCT WITHIN 100mm OF THE DESIGN LANDSCAPE ELEVATION & ILLUSTRATED DRAINAGE PATTERNS UNLESS OTHERWISE APPROVED BY THE DEVELOPMENT OFFICER.
6. IF THE INFORMATION ON THIS CERTIFICATE HAS BEEN PREPARED BY A PRIVATE DEVELOPER OR THEIR AGENT, THE CITY OF RED DEER ACCEPTS NO RESPONSIBILITY FOR ITS ACCURACY.

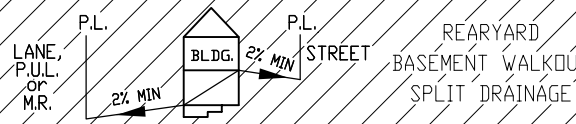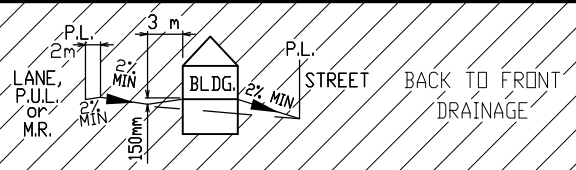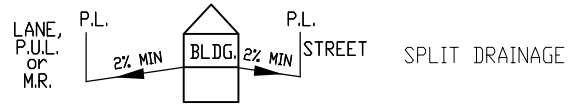

- LEGEND**
- SAN, WATER & STORM
 - ⊙ FIRE HYDRANT
 - - - GAS
 - ☀ POWER, TELEPHONE & CABLE SERVICE
 - ⊙ STREET LIGHT
 - ⊠ COMMUNITY MAILBOX
 - TRANSFORMER
 - EL&P TRANSFORMER
 - SHAW PEDESTAL
 - ▲ TELEPHONE PEDESTAL
 - URD BOX

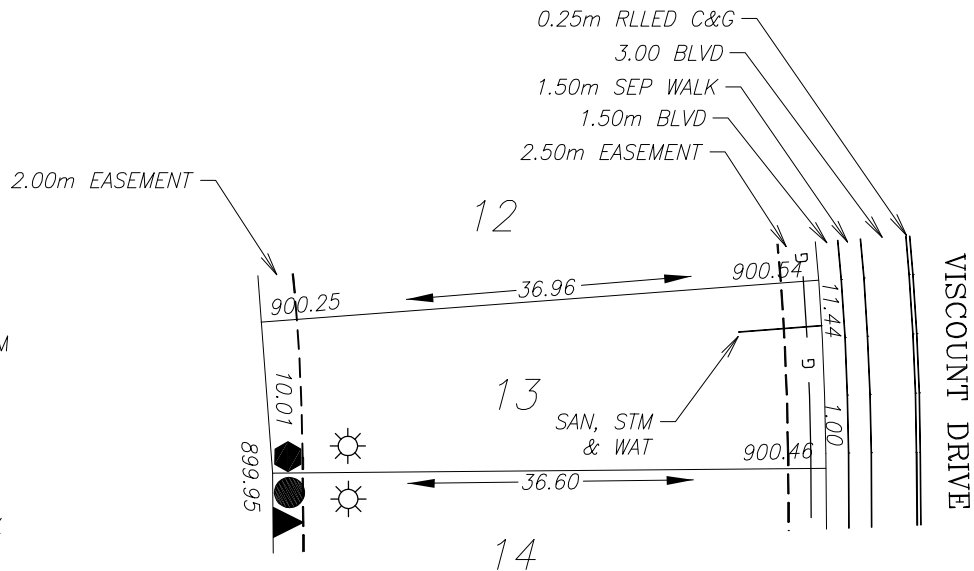

POWER SERVICE LOCATION IS 1.0m FROM SIDEYARD LOTLINE
 SANITARY AND WATER SERVICE LOCATION IS 3.0m FROM SIDEYARD LOTLINE

TOP OF FOOTING:
 MAX. DEPTH BELOW AVERAGE SIDEWALK = 2.14
 LOWEST ELEVATION = 898.36

AS-BUILT SEWER INVERT ELEVATIONS:
 SANITARY AT 5.0m INSIDE LOT = 897.51
 STORM AT 5.0m INSIDE LOT = 897.51

CIVIC ADDRESS: 310 VISCOUNT DRIVE
 LOT: 13 BLOCK: 1 PLAN No.: 132 4102
 DEVELOPER: MELCOR DEVELOPMENTS SCALE: 1:500
 DRAWN BY: STANTEC CONSULTING LTD DATE: Sep 26, 2013
 APPROVED BY: KERRY SAUNDERS DATE: Sep 27, 2013
 RECEIVED BY: _____ DATE: _____


DESIGN LANDSCAPE ELEVATIONS
 ELEV. AT FRONT OF HOUSE = 900.84
 ELEV. AT REAR OF HOUSE = 900.60

I CERTIFY THAT THE FINAL LANDSCAPE GRADE WILL BE (FRONT) _____
 (REAR) _____
 SIGNATURE OF OWNER OR REPRESENTATIVE _____


BUILDING GRADE CERTIFICATE

City of Red Deer
 Issued by: _____ No. _____

1. WHEN EXCAVATING IN A RIGHT OF WAY (EASEMENT), CHECK FOR UTILITIES.
2. STANDING AT THE WATER SHUTOFF AND FACING THE BUILDING, THE SANITARY SERVICE (PAINTED RED) IS ON THE LEFT SIDE OF THE WATER SERVICE; STORM SERVICE (PAINTED GREEN) IS ON THE RIGHT SIDE OF THE WATER SERVICE.
3. ALL DIMENSIONS ARE IN METRES AND DECIMALS THERE OF. THE ELEVATIONS ARE IN METRES ABOVE GEODETIC MEAN SEA LEVEL.
4. ELEVATIONS NOTED ON THE CERTIFICATE ARE WITHIN 100mm OF ACTUAL.
5. THE BUILDER MUST CONSTRUCT WITHIN 100mm OF THE DESIGN LANDSCAPE ELEVATION & ILLUSTRATED DRAINAGE PATTERNS UNLESS OTHERWISE APPROVED BY THE DEVELOPMENT OFFICER.
6. IF THE INFORMATION ON THIS CERTIFICATE HAS BEEN PREPARED BY A PRIVATE DEVELOPER OR THEIR AGENT, THE CITY OF RED DEER ACCEPTS NO RESPONSIBILITY FOR ITS ACCURACY.

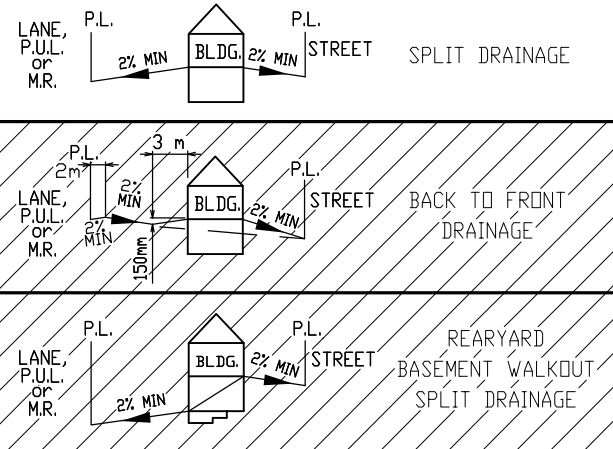

- LEGEND**
- SAN, WATER & STORM
 - ⊙ FIRE HYDRANT
 - - - GAS
 - ☀ POWER, TELEPHONE & CABLE SERVICE
 - STREET LIGHT
 - ⊠ COMMUNITY MAILBOX
 - TRANSFORMER
 - EL&P TRANSFORMER
 - SHAW PEDESTAL
 - ▲ TELEPHONE PEDESTAL
 - URD BOX

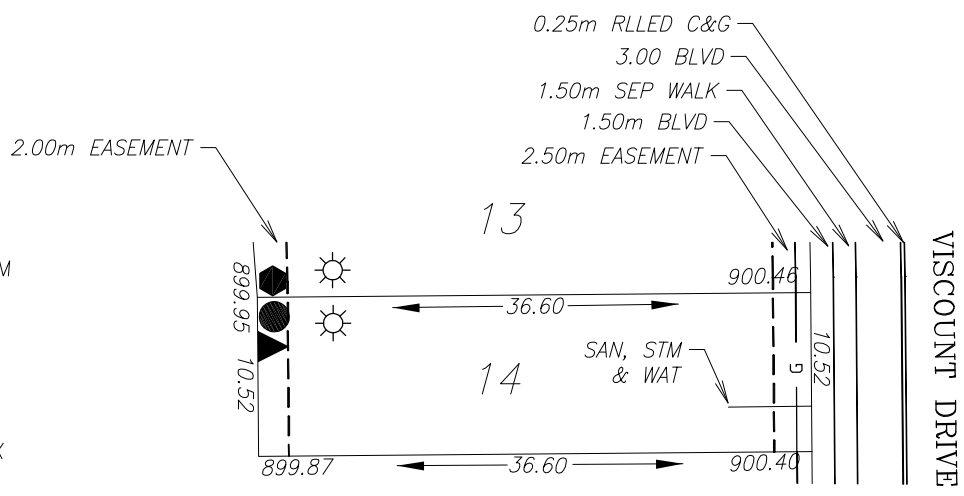

POWER SERVICE LOCATION IS 1.0m FROM SIDEYARD LOTLINE
 SANITARY AND WATER SERVICE LOCATION IS 3.0m FROM SIDEYARD LOTLINE

TOP OF FOOTING:
 MAX. DEPTH BELOW AVERAGE SIDEWALK = 2.15
 LOWEST ELEVATION = 898.28

AS-BUILT SEWER INVERT ELEVATIONS:
 SANITARY AT 5.0m INSIDE LOT = 897.43
 STORM AT 5.0m INSIDE LOT = 897.43

CIVIC ADDRESS: 306 VISCOUNT DRIVE
 LOT: 14 BLOCK: 1 PLAN No.: 132 4102
 DEVELOPER: MELCOR DEVELOPMENTS SCALE: 1:500
 DRAWN BY: STANTEC CONSULTING LTD DATE: Sep 26, 2013
 APPROVED BY: KERRY SAUNDERS DATE: Sep 27, 2013
 RECEIVED BY: _____ DATE: _____

DESIGN LANDSCAPE ELEVATIONS
 ELEV. AT FRONT OF HOUSE = 900.76
 ELEV. AT REAR OF HOUSE = 900.30

I CERTIFY THAT THE FINAL LANDSCAPE GRADE WILL BE (FRONT) _____
 (REAR) _____
 SIGNATURE OF OWNER OR REPRESENTATIVE _____